

MAY 28 1997

COMMISSION

OGEMAW COUNTY REMONUMENTATION

CIBER

3

PAGE

70

LAND CORNER RECORDATION CERTIFICATE  
Filing Requirement of Act 74, Mich. P.A. 1970

For corners in

Ogemaw	Located in:	Corner Code #
(County)		
1. Public Land Survey	T 22N R 1E	M - 3 ✓
	T 22N R 2E	A - 3
	T R	
	T R	
2. Property Controlling	S T R	
in Section	S T R	
3. Miscellaneous	S T R	
Property in Sec.	S T R	

STATE OF MICHIGAN  
OGEMAW COUNTY  
RECORDED

30 DEC 96 4:27 P.M.

WANDA MUZIK  
REGISTER OF DEEDS

Register of Deeds Stamp & File Number

4. Lot No. \_\_\_\_\_, Recorded Plat \_\_\_\_\_  
5. Private Claims \_\_\_\_\_

I, Timothy L. Lapham, in a field survey on December, 19 96 do hereby state that under requirements of P.A. 74, Michigan P.A. of 1970, the corner points mentioned in lines 1 and 2 above were in conformance with regulations and rules therefore as required in the current manual of survey instructions of the United States Department of the Interior, Bureau of Land Management or by a decree of a Court of Law and/or that the corner points mentioned in lines 3, 4 and 5 above were in conformance with the rules of the Michigan Board of Land Surveyors or by a Decree of a Court of Law; established, re-established, monumented, recovered, found as expressed below:

NOTE: Not more than 2 corners, all in the same town and range, may be recorded on this certificate.

	A	B	C	D	E	F	G	H	I	J	K	L	M
1													
2	6			5			4		3		2		1
3													
4	7			8			9		10		11		12
5													
6	18			17			16		15		14		13
7													
8	19			20			21		22		23		24
9													
10	30			29			28		27		26		25
11													
12	31			32			33		34		35		36
13													

A. Description of original monument and accessories and/or subsequent restoration:

Note: Corner Common to A-3 T22N R2E

GLO L. Clason 1838

Set post

Y. Pine 18 S66W 21 links

W. Pine 30 N41W 30 links

GLO B.F. Hall 1848

Found post


W. Pine 22 N73-1/2E 83 links

Survey, Richardson, 8/74

No material or witnesses

B. Description of corner evidence found and/or method applied in restoring or reestablishing corner:

No evidence of GLO found. Found 2" pipe at intersection of trails and four apparent witness trees. Accepted as best evidence of the position of the original corner. See dossier for additional information.

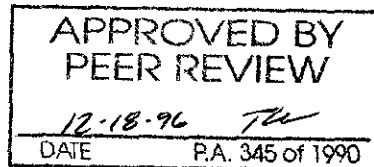

C. Description of monument for corner and accessories established to perpetuate locating the position of the corner:

Set 5/8" X 36" rerod with 2-1/4" Aluminum cap marked "1896 27595"

From Which:


N50E 28.79' 5" Maple

S40W 34.52' 14" W. Oak

S64W 21.63' 8" Maple

N30W 33.52' 8" Maple

Monument located 5' South of centerline trail East-West and 3' East of centerline trail North-South

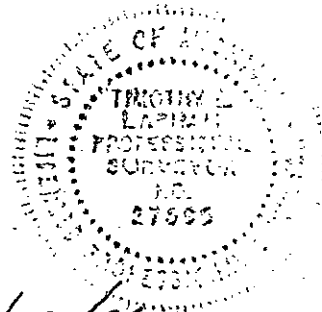

Signed by [Signature]

Date 12/27/96

Surveyor's Michigan License No. 27595