

SURVEY & REMONUMENTATION

MAY 28 1997

COMMISSION

OGEMAW COUNTY REMONUMENTATION

LAND CORNER RECORDATION CERTIFICATE
Filing Requirement of Act 74, Mich. P.A. 1970

LIBER 23 PAGE 71

For corners in

Ogemaw
(County)

Located in:

Corner Code #

1. Public Land Survey

T 22N R 1E

T 22N R 2E

T R

T R

A-4

2. Property Controlling
in Section

S

S

S

S

3. Miscellaneous
Property in Sec.

S

S

S

4. Lot No. , Recorded Plat

5. Private Claims

I, Timothy L. Lapham, in a field survey on December, 19 96 do hereby state that under requirements of P.A. 74, Michigan P.A. of 1970, the corner points mentioned in lines 1 and 2 above were in conformance with regulations and rules therefore as required in the current manual of survey instructions of the United States Department of the Interior, Bureau of Land Management or by a decree of a Court of Law and/or that the corner points mentioned in lines 3, 4 and 5 above were in conformance with the rules of the Michigan Board of Land Surveyors or by a Decree of a Court of Law; established, re-established, monumented, recovered, found as expressed below:

NOTE: Not more than 2 corners, all in the same town and range, may be recorded on this certificate.

A. Description of original monument and accessories and/or subsequent restoration:

Note: Corner common to A-4 T22N R2E

GLO L. Clason 1838

Set post

Cedar 9 S27W 19 links

Cedar 12 N75W 16 links

LCRC, Cavanagh, 4/73 (Rec L1, P37)

Found 5/8" bar, 3 wits;

LCRC, Cavanagh, 1/75 (Rec L1, P201)

Found 5/8" iron, 3 wits;

Survey, Cavanagh, 2/75 (Rec L1, P552)

Found 5/8" iron, 3 wits;

Survey, Higgins, 7/78 (Rec L2, P515)

Found 5/8" bar of record, no wits;

B. Description of corner evidence found and/or method applied in restoring or reestablishing corner:

No evidence of GLO corner found, Distance South to Creek matches GLO. Found 5/8" iron and three Cavanagh witnesses. Distance South to M-5 in accord with recorded surveys by Cavanagh & Higgins. Accepted found iron as best evidence of the position of the original corner. See dossier for additional information.

APPROVED BY
PEER REVIEW

12-18-96 TL

DATE

P.A. 345 of 1990

C. Description of monument for corner and accessories established to perpetuate locating the position of the corner:

Set 5/8" X 36" rerod with 2-1/4" Aluminum cap marked "1996 27595"

From Which:


N01E 49.96' 12" Cedar

N88E 12.27' 8" Cedar

S30E 37.24' 12" Cedar

S34W 51.90' 15" Maple

Monument located 23.5' west of Centerline Dow road.

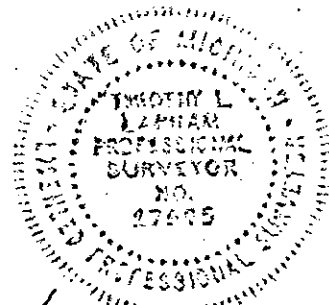

Signed by

Surveyor's Michigan License No. 27595

Date

12/27/96