

# REMONUMENTATION

OGEMAW COUNTY REMONUMENTATION

MAY 28 1997

## LAND CORNER RECORDATION CERTIFICATE Filing Requirement of Act 74, Mich. P.A. 1970

LIBER 3 PAGE 75

STATE OF MICHIGAN  
OGEMAW COUNTY  
RECORDED

For corners in COMMISSION

30 DEC 96 4:28 P.M.

WANDA HUZIK  
REGISTER OF DEEDS

Ogemaw Located In: Corner Code #

1. Public Land Survey

T 22N R 1E M-8  
T 22N R 2E A-8  
T R  
T R  
2. Property Controlling  
in Section

S

3. Miscellaneous  
Property in Sec.

S  
S  
S

4. Lot No. , Recorded Plat  
5. Private Claims

I, Timothy L. Lapham, in a field survey on December, 1996 do hereby state that under requirements of P.A. 74, Michigan P.A. of 1970, the corner points mentioned in lines 1 and 2 above were in conformance with regulations and rules therefore as required in the current manual of survey instructions of the United States Department of the Interior, Bureau of Land Management or by a decree of a Court of Law and/or that the corner points mentioned in lines 3, 4 and 5 above were in conformance with the rules of the Michigan Board of Land Surveyors or by a Decree of a Court of Law; established, re-established, monumented, recovered, found as expressed below:

NOTE: Not more than 2 corners, all in the same town and range, may be recorded on this certificate.

	A	B	C	D	E	F	G	H	I	J	K	L	M
1													
2	6			5			4		3		2		1
3													
4	7			8			9		10		11		12
5													
6	18			17			16		15		14		13
7													
8	19			20			21		22		23		24
9													
10	30			29			28		27		26		25
11													
12	31			32			33		34		35		36
13													

### A. Description of original monument and accessories and/or subsequent restoration:

Note: Corner Common to A-8 T22N R2E

GLO, L. Clason 1838

Set post

Cedar 5 S66W 19 links

B. Ash 5 N29W 4 links

Survey, Cavanagh 11/71 (Rec L1, P35)

Found 1/2" pipe, no wits;

Survey, Cavanagh 5/74 (Rec L1, P390)

Found pipe, no wits;

Survey, Higgins 6/76 (Rec L2, P109)

Found pipe of record, no wits;

Survey, Higgins 1/77 (Rec L2, P227)

No corner material or wits;

Survey, Higgins 9/78 (Rec L2, P531)

Found 1/2" bar, 3 Wits;

Survey, Higgins 10/78 (Rec L2, P523)

1/2" bar of record

Survey, Ledy, 11/83 (Rec L3, P454)

1/2" bar, 3 wits;

LCRC, Lapham 3/93 (Rec L2, P200)

Capped Iron, 3 Wits;


Plat, Holms, 2/1889 "Hauptman's Addition" (Rec L1,

P7)

No material or Witnesses;

### B. Description of corner evidence found and/or method applied in restoring or reestablishing corner:

No evidence of GLO corner found. Found 1/2" capped iron and three Lapham witnesses. Distance North to M-7 in accord with recorded surveys. Distance North to GLO Topo calls matches proportionate GLO distance. Accepted as best evidence of the position of the original corner.

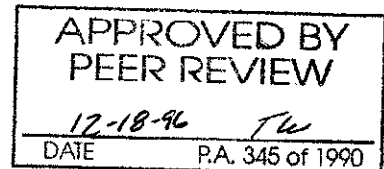

### C. Description of monument for corner and accessories established to perpetuate locating the position of the corner:

Set 5/8" X 36" rebar with 2-1/4" Aluminum cap marked "1996 27595"

In Monument Box

From Which:


N36E 73.48' Utility Pole

S72E 50.51' 6" Spruce

S28W 73.58' Utility pole

N22W 87.06' Utility Pole

Monument located 5' West of centerline Dow Road North-South and 5' South of centerline driveway West

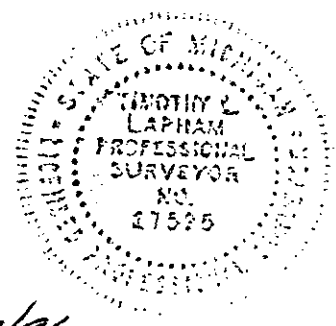

Signed by [Signature]  
Surveyor's Michigan License No. 27595

Date 12/27/96