

LAND CORNER RECORDATION CERTIFICATE

Filing Requirement of Act 74, Mich. PA 1970

Recd Ogemaw Cnty 081512PM02:03

For Corners In:
OGEMAW
(County)

Located In

Corner Code #

1. Public Land Survey T R
T R
2. Property Controlling
in Section S 5 T 22N R 3E 2
S 5 T 22N R 3E 9
3. Miscellaneous
Property in Section S T R
S T R

Register of Deeds Stamp & File Number

4. Lot No: Recorded Plat:

5. Private Claims:

I, Carl T. Kiiskila, in a field survey on March 15, 2012 do hereby state that under requirements of PA 74, Michigan PA of 1970, the corner points mentioned in lines 1 and 2 above were in conformance with regulations and rules therefore as required in the current manual of survey instructions of the United States Department of the Interior, Bureau of Land Management or by a decree of a Court of Law and/or that the corner points mentioned in lines 3, 4 and 5 above were in conformance with the rules of the Michigan Board of Land Surveyors or by a Decree of a Court of Law; established, re-established, monumented, recovered, found as expressed below:

NOTE: Not more than 2 corners, all in the same town and range, may be recorded on this certificate.

	A	B	C	D	E	F	G	H	I	J	K	L	M
1													
2	6			5		4		3		2		1	
3													
4	7		8		9		10		11		12		
5													
6	18		17		16		15		14		13		
7													
8	19		20		21		22		23		24		
9													
10	30		29		28		27		26		25		
11													
12	31		32		33		34		35		36		
13													

A. Description of original monument and accessories and/or subsequent restoration:

2 - East 1/16 corner North line section 5, T22N,R03E

9-CE 1/16 corner section 5, T22N,R03E

This corner was not established during the Original Government Survey

This corner was not established during the Original Government Survey

Doc # 3107417 L: 6 P: 293
08/15/2012 02:07:37 PM Page: 1 of 1
SURC Fee: \$ 14.00
Denise Simmons, Ogemaw Co Register



B. Description of corner evidence found and/or method applies in restoring or re-establishing corner:

2 - East 1/16 corner North line section 5, T22N,R03E

9-CE 1/16 corner section 5, T22N,R03E

Set stamped 2" dia. aluminum cap on 5/8" x 34" rebar per standard BLM procedure. Found no other evidence to dispute the location for the corner.

Set stamped 2" dia. aluminum cap on 5/8" x 34" rebar per standard BLM procedure. Found no other evidence to dispute the location for the corner.

C. Description of monument for corner and accessories established to perpetuate locating the position of the corner:

2 - East 1/16 corner North line section 5, T22N,R03E
2" dia. aluminum cap on 5/8" x 34" rebar

9-CE 1/16 corner section 5, T22N,R03E
2" dia. aluminum cap on 5/8" x 34" rebar

Wit: N21°E 31.92' to set N&T on S side 10" Balsam
S50°E 52.77' to set N&T on S side 17" Spruce
S4°E 34.51' to set N&T on E side 9" Balsam
N26°W 37.14' to set N&T on E side 6" Tamarack
Centerline of Gravel Road 1' North

Wit: N25°E 35.51' to set N&T on SE side 7" Balsam
S38°E 8.00' to set N&T NE side 8" Poplar
S18°W 11.12' to set N&T SE side 8" Poplar
N55°W 1.09' to set N&T SW side 8" Poplar
North 37' to East - West wire fence
N72°E 203' to Fence Corner wire N&W

Set Blue Carsonite Post w/ location tag 33' South


Set Blue Carsonite Post w/ location tag 1' North

Signed by:

Carl T. Kiiskila

Surveyor's Michigan License No.:

33981

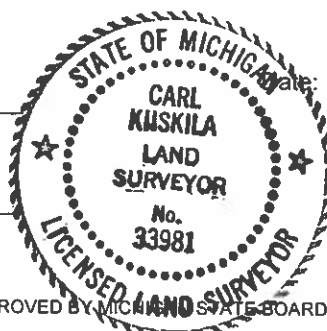

8-15-12