

LAND CORNER RECORDATION CERTIFICATE

Filing Requirement of Act 74, Mich. PA 1970

Rec'd Ogemaw Cnty 08/15/12 PM 02:03

For Corners In:

OGEMAW

(County)

Located In

Corner Code #

1. Public Land Survey	T	22N	R	3E	D-3
	T		R		
2. Property Controlling in Section	S	5	T	22N	R 3E 14
	S		T		
3. Miscellaneous Property in Section	S		T		R
	S		T		R


4. Lot No: _____ Recorded Plat: _____

5. Private Claims: _____

I, Carl T. Kiiskila, in a field survey on March 15, 2012 do hereby state that under requirements of PA 74, Michigan PA of 1970, the corner points mentioned in lines 1 and 2 above were in conformance with regulations and rules therefore as required in the current manual of survey instructions of the United States Department of the Interior, Bureau of Land Management or by a decree of a Court of Law and/or that the corner points mentioned in lines 3, 4 and 5 above were in conformance with the rules of the Michigan Board of Land Surveyors or by a Decree of a Court of Law; established, re-established, monumented, recovered, found as expressed below:

NOTE: Not more than 2 corners, all in the same town and range, may be recorded on this certificate.

Register of Deeds Stamp & File Number

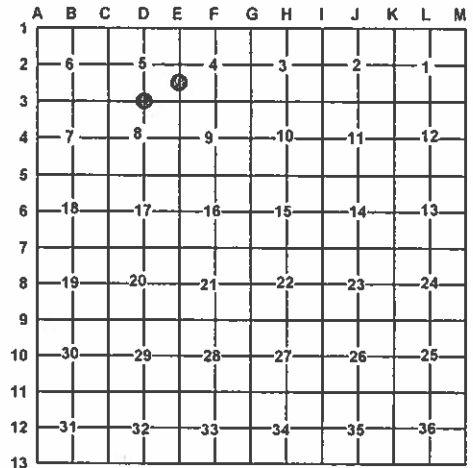

A. Description of original monument and accessories and/or subsequent restoration:

D-3 - 1/4 corner common to sections 5&8, T22N,R03E

14-S 1/16 corner on East Line section 5, T22N,R03E

1846 - G.L.O. B.J. Hall used a W. Pine 24" in diameter for quarter section post.

1960 - James E. Richardson RLS #2527 set a concrete monument by standard BLM procedure.

1960 - James E. Richardson RLS #2527 set 1/2" bar by single proportionate measurement.

Doc # 3107418 L: 6 P: 294
08/15/2012 02:07:37 PM Page: 1 of 1
SURC Fee: \$ 14.00
Denise Simmons, Ogemaw Co Register



B. Description of corner evidence found and/or method applies in restoring or re-establishing corner:

D-3 - 1/4 corner common to sections 5&8, T22N,R03E

14-S 1/16 corner on East Line section 5, T22N,R03E

Found 1/2" bar as set by James Richardson. Drove 1"x36" pipe w/ P.S. Cap #33981 over found 1/2" bar.

Found Concrete Monument as set By James Richardson

C. Description of monument for corner and accessories established to perpetuate locating the position of the corner:

D-3 - 1/4 corner common to sections 5&8, T22N,R03E

14-S 1/16 corner on East Line section 5, T22N,R03E
Concrete Monument

1"x36" pipe w/ P.S. cap #33981.

Wit: S58°E 71.38' to set nail on power pole
S4°W 59.43' to set N&T on E side 22" W. Pine
N58°W 32.04' to set N&T on SW side 9" Spruce
N11°W 19.98' to set N&T on W side 6" Spruce

Wit: N78°E 2.47' to set N&T on S side 6" Maple
S66°E 4.91' to set N&T on N side 6" Maple
S32°W 1.95' to set N&T on E side 4" Balsam
N5°W 2.57' to set N&T on W side 3" Balsam

Centerline of East-West Road 8' South

Centerline of East-West Power Line 25' South

Signed by:

Carl T. Kiiskila

Surveyor's Michigan License No.:

33981



Date:

8-15-12