

SURVEY &  
REMONUMENTATION

JUN 02 1994

OGEMAW COUNTY REMONUMENTATION

LAND CORNER RECORDATION CERTIFICATE  
Filing Requirement of Act 74, Mich. P.A. 1970

COMMISSION

For corners in

OGEMAW

(County)

Located In:

Corner Code ##

1. Public Land Survey T 22N R 3E M-2  
T \_\_\_\_\_ R \_\_\_\_\_  
T \_\_\_\_\_ R \_\_\_\_\_  
T \_\_\_\_\_ R \_\_\_\_\_
2. Property Controlling S \_\_\_\_\_ T \_\_\_\_\_ R \_\_\_\_\_  
in Section S \_\_\_\_\_ T \_\_\_\_\_ R \_\_\_\_\_
3. Miscellaneous S \_\_\_\_\_ T \_\_\_\_\_ R \_\_\_\_\_  
Property in Sec. S \_\_\_\_\_ T \_\_\_\_\_ R \_\_\_\_\_

4. Lot No. \_\_\_\_\_, Recorded Plat \_\_\_\_\_
5. Private Claims \_\_\_\_\_

LIBER 2 PAGE 218

93 DEC 29 PM 2:57

Wanda Muzik  
REGISTER OF DEEDS  
OGEMAW COUNTY

Register of Deeds Stamp & File Number

TIMOTHY L. LAPHAM, in a field survey on December, 1993,  
do hereby certify that under requirements of P.A. 74, Michigan P.A. of 1970, the corner points mentioned  
in lines 1 and 2 above were in conformance with regulations and rules therefore as required in the  
current manual of survey instructions of the United States Department of the Interior, Bureau of Land  
Management or by a decree of a Court of Law and/or that the corner points mentioned in lines 3, 4 and 5  
above were in conformance with the rules of the Michigan Board of Land Surveyors or by a Decree of a  
Court of Law, established, re-established, monumented, re-monumented, recovered, found as  
expressed below:

NOTE: Not more than 4 corners, all in the same town and range, may be recorded  
on this certificate.

A. Description of original monument and accessories and/or subsequent restoration:


M-2: 1838, CLASON, POST, HEMLOCK 10" S49°W 35L, BLACK ASH 10" N66°W 24L;  
1978+/- OGEMAW COUNTY ROAD PLANS, CORNER MATERIAL, 3 WITNESSES;  
8/15/1983, R. HIGGINS, (132) 3-426, CORNER, 3 WITNESSES;  
1/14/1985, T. LAPHAM, (132) NOT REC, CORNER, 4 WITNESSES;  
1/27/1988, D. LEDY, (132) 1-373, CORNER, 3 WITNESSES;  
1992 T. LAPHAM, (132) NOT REC, CORNER, 3 WITNESSES.

B. Description of corner evidence found and/or method applied in restoring or reestablishing corner:

M-2: NO EVIDENCE OF GLO CORNER OR WITNESSES FOUND. CORNER OUT DUE TO RECENT ROAD CONSTRUCTION.  
RESET CORNER FROM FOUND WITNESSES:  
14" MAPLE S81°W 57.8'  
POWER POLE S79°W 53.73'  
ACCEPTED REESTABLISHED CORNER AS BEST EVIDENCE OF LOCATION OF ORIGINAL CORNER.  
THIS CORNER ESTABLISHED IN OGEMAW COUNTY REMONUMENTATION PROGRAM.  
SEE DOSSIER FOR DETAILED REPORT.

C. Description of monument for corner and accessories established to perpetuate locating the position of the corner:

M-2: SET 5/8" X 36" REROD WITH 3" OGEMAW COUNTY MONUMENT CAP.  
AZ 299° 66.40' SPIKE NE FACE 38" COTTONWOOD  
AZ 101° 53.73' SPIKE SOUTH FACE POWER POLE  
AZ 90° 9' +/- CENTER LINE GRAVEL ROAD  
AZ 71° 63.75' SPIKE SE FACE 6" WILLOW  
AZ 345° 128.53' SPIKE NE FACE 15" POPLAR

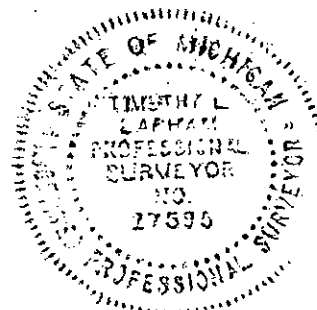

Signed by

Date

Surveyor's Michigan License No. 27595