

JEC 21 2000

SECTION

LAND CORNER RECORDATION CERTIFICATE
Filing Requirement of Act 74, Mich. P.A. 1970

For corners in

Oscoda

(County)

Located In:

Corner Code #

1. Public Land Survey

T 27N R 2E

F-5

T R

T R

T R

2. Property Controlling
in Section

S T R

S T R

3. Miscellaneous
Property in Sec.

S T R

S T R

4. Lot No. , Recorded Plat

5. Private Claims

I, Marvin E. Myers, in a field survey on June 16, 2000 do hereby state that under requirements of P.A. 74, Michigan P.A. of 1970, the corner points mentioned in lines 1 and 2 above were in conformance with regulations and rules therefore as required in the current manual of survey instructions of the United States Department of the Interior, Bureau of Land Management or by a decree of a Court of Law and/or that the corner points mentioned in lines 3, 4 and 5 above were in conformance with the rules of the Michigan Board of Land Surveyors or by a Decree of a Court of Law; established, re-established, monumented, recovered, found as expressed below:

NOTE: Not more than 2 corners, all in the same town and range, may be recorded on this certificate.

A. Description of original monument and accessories and/or subsequent restoration.

$\frac{1}{4}$ corner common to Section 9 and 16, T27N, R2E

G.L.O. - 1839 William R. Coon D.S. 1969 L2, P169 N.C. Caldwell, #12018

Mon - Post

Mon - Standard County Cap & Pipe

Wit: 6" Spr. Pine S28°E 56

Wit: 20" Oak S15°W 38.3

4" Spr. Pine N28°W 1.02

7" Oak N35°E 22.9

9" Jackpine S68°W 63.2

1/2" Bar & Post South 33.0

B. Description of corner evidence found and/or method applied in restoring or reestablishing corner:

$\frac{1}{4}$ corner common to Section 9 and 16, T27N, R2E

Found Standard County Corner 1 foot deep; found $\frac{1}{2}$ " bar South 33.0. Accepted Standard County Corner as a careful and faithful reestablishment of the Government Corner.

C. Description of monument for corner and accessories established to perpetuate locating the position of the corner:

$\frac{1}{4}$ corner common to Section 9 and 16, T27N, R2E

Mon - Standard Oscoda County Corner Monument.

Wit: Nail & tag SE side 20" Oak N41°E 23.63

Nail & tag SW side 8" J. Pine N35°W 20.14


Nail & tag W. side Utility Pole S28°W 30.95

Nail & tag NE side 20" Norway S36°E 63.89

APPROVED

County Remonumentation
Peer Review Group

NCC
27 JULY 00

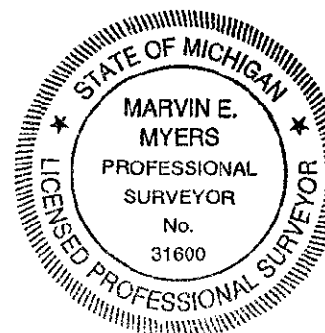

Signed by

Marvin E. Myers

Date July 10, 2000

Surveyor's Michigan License No. 31600