

MAR 17 2000

OTSEGO COUNTY REMONUMENTATION

SECTION

LAND CORNER RECORDATION CERTIFICATE  
Filing Requirement of Act 74, Mich. P.A. 1970  
Also Act 345, PA 1990

OTSEGO COUNTY  
MICHIGAN  
RECEIVED FOR RECORD

99 DEC 27 PM 2:56

EVLETH M. PRATT  
CLERK / REGISTER OF DEEDS

For corners in

<u>Otsego</u> (County)	Located In:	Corner Code #
1. Public Land Survey	T <u>29N</u> R <u>1W</u>	<u>K-13</u>
	T <u>    </u> R <u>    </u>	<u>    </u>
	T <u>    </u> R <u>    </u>	<u>    </u>
	T <u>    </u> R <u>    </u>	<u>    </u>
2. Property Controlling in Section	S <u>    </u> T <u>    </u> R <u>    </u>	<u>    </u>
	S <u>    </u> T <u>    </u> R <u>    </u>	<u>    </u>
3. Miscellaneous Property in Sec.	S <u>    </u> T <u>    </u> R <u>    </u>	<u>    </u>
	S <u>    </u> T <u>    </u> R <u>    </u>	<u>    </u>
4. Lot No. <u>        </u> , Recorded Plat <u>        </u>		
5. Private Claims <u>        </u>		

Register of Deeds Stamp & File Number

I, James L. Schwandt, in a field survey on Jan. 19, 1999, do hereby state that under requirements of P.A. 74, Michigan P.A. of 1970, the corner points mentioned in lines 1 and 2 above were in conformance with regulations and rules therefore as required in the current manual of survey instructions of the United States Department of the Interior, Bureau of Land Management or by a decree of a Court of Law and/or that the corner points mentioned in lines 3, 4 and 5 above were in conformance with the rules of the Michigan Board of Land Surveyors or by a Decree of a Court of Law; established, re-established, monumented, recovered, found as expressed below:

NOTE: Not more than 4 corners, all in the same town and range, may be recorded on this certificate.

A. Description of original monument and accessories and/or subsequent restoration:

G.L.O. James Mullett, 1839  
Set Post  
Pine 10", N77°W, 38 links  
Black Oak 8", N72°E, 28 links

Dean Delamater, 1952  
Set 1" pipe with brass cap  
14" Black Oak, S60°W, 21 links  
24" R. Pine, N10°W, 148 links

1" pipe w/brass cap placed by double proportional measurement by Conservation Dept., Sept. 4, 1952. Recorded by S.O. Thorson, #5788,3-10-53  
Black Oak, 14" S60°W, 21 links  
R. Pine 24", N10°E, 148 links  
Corner reset April 1968 by single proportion by Kenneth Ostling for Conservation Dept in April 1968, recorded by  
S. Thorson, 10-29-68  
8" Oak, S65°W, 20.7'  
11" Oak, S13°W, 18.1'


Larry Beauregard #18654, 1986  
Found DNR corner  
S65°W, 20.7', 12" Oak  
S11°W, 18.1', 15" Oak

B. Description of corner evidence found and/or method applied in restoring or reestablishing corner:

Found Department of Conservation Monument, 1" pipe with brass cap from 1968  
Found 14" Black Oak, S13°W, 18.1' to face  
Found 10" Black Oak, S65°W, 20.7' to face

C. Description of monument for corner and accessories established to perpetuate locating the position of the corner:

Department of Conservation Monument in corner is accepted as a careful and faithful reestablishment of the position of the original corner.  
Spike in found 14" Black Oak, S13°W, 18.51'  
Spike in found 10" Black Oak, S65°W, 21.04'  
Spike 26" Black Oak, North 44.07'  
Spike 8" J. Pine, S20°E, 7.49'

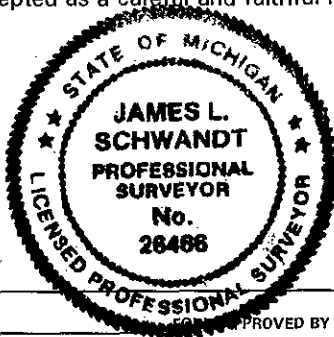

OTSEGO COUNTY REMONUMENTATION

Approved by the County Survey Peer  
Group, pursuant to Act 345, PA 1990  
Dec. 17, 1999  
Date  
Chairman

Signed by James L. Schwandt  
Surveyor's Michigan License No. 26466

Date 12-23-99