

LAND CORNER RECORDATION CERTIFICATE

Filing Requirement of Act 74, Mich. PA 1970

For Corners In:
Otsego
(County)

Located In Corner Code #

1. Public Land Survey T R
T R
2. Property Controlling in Section S 20 T 30N R 03W 10
S T R
3. Miscellaneous Property in Section S T R
S T R

4. Lot No: Recorded Plat:

5. Private Claims:

I, Carl T. Kiiskila, in a field survey on July 12, 2005 do hereby state that under requirements of PA 74, Michigan PA of 1970, the corner points mentioned in lines 1 and 2 above were in conformance with regulations and rules therefore as required in the current manual of survey instructions of the United States Department of the Interior, Bureau of Land Management or by a decree of a Court of Law and/or that the corner points mentioned in lines 3, 4 and 5 above were in conformance with the rules of the Michigan Board of Land Surveyors or by a Decree of a Court of Law, established, re-established, monumented, recovered, found as expressed below:

NOTE: Not more than 2 corners, all in the same town and range, may be recorded on this certificate.

A. Description of original monument and accessories and/or subsequent restoration:

10- This corner position was not established during the original government survey.

B. Description of corner evidence found and/or method applies in restoring or re-establishing corner:

10- Established the Northwest corner of the Southwest quarter of the Southwest quarter of section 20 as per B.L.M. instructions for the subdivision of a section.

C. Description of monument for corner and accessories established to perpetuate locating the position of the corner:

10- Set a 5/8" X 32" capped iron rod with P.S. cap #33981


Wit: 10" White Pine N62°E 49.92'
9" Red Pine S46°E 47.95'
22" White Pine S55°W 66.40'
Power Pole N05°W 88.59'
Blue Carsonite Post East 33'±
Centerline of Fowler Lk. Rd. East 2'±

LIBER 0005 PAGE 125



OTSEGO COUNTY MICHIGAN
RECEIVED FOR RECORD
SUSAN DEFEYTER, CLERK/REGISTER OF DEED
07/20/2005 3:09:08 PM

Register of Deeds Stamp & File Number

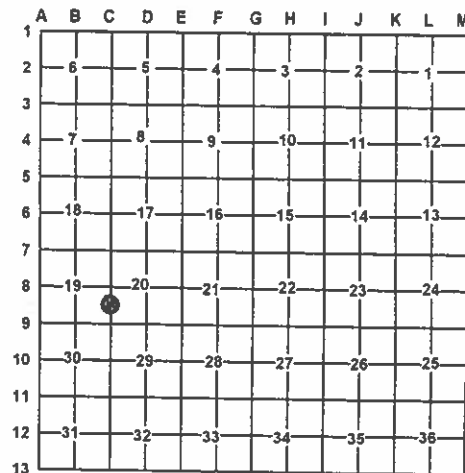

LIBER 0005 PAGE 125



Signed by:

Carl T. Kiiskila

Date:

7/14/05

Surveyor's Michigan License No.:

33981