

SURVEY & REMONUMENTATION

FEB 27 1998

OTTAWA COUNTY REMONUMENTATION LAND CORNER RECORDATION CERTIFICATE Filing Requirement of Act 74, Mich. P.A. 1970

RECORDED

97 DEC -8 AM 11:38

Larry Schell
REGISTER OF DEEDS
OTTAWA COUNTY, MI

For corners in

OTTAWA

(County)

Located in:

Corner Code #

1. Public Land Survey

T___ R___
T___ R___
T___ R___
T___ R___

B 2-3 North witness

cor. for B-3,

Jamestown

2. Property Controlling
in Section

S 6 T 5N R 13W

Sequential
Corner #1

3. Miscellaneous
Property in Sec.

S___ T___ R___
S___ T___ R___
S___ T___ R___

Register of Deeds Stamp & File Number

4. Lot No. _____, Recorded Plat _____
5. Private Claims _____

I, Randal J. Vugteveen, in a field survey on October 16, 1997 do hereby state that under requirements of P.A. 74, Michigan P.A. of 1970, the corner points mentioned in lines 1 and 2 above were in conformance with regulations and rules therefore as required in the current manual of survey instructions of the United States Department of the Interior, Bureau of Land Management or by a decree of a Court of Law and/or that the corner points mentioned in lines 3, 4 and 5 above were in conformance with the rules of the Michigan Board of Land Surveyors or by a Decree of a Court of Law; established, re-established, monumented, recovered, found as expressed below:

NOTE: Not more than 2 corners, all in the same town and range, may be recorded on this certificate.

	A	B	C	D	E	F	G	H	I	J	K	L	M
1													
2		6		5		4		3		2		1	
3													
4		7		8		9		10		11		12	
5													
6		16		17		16		15		14		13	
7													
8		19		20		21		22		23		24	
9													
10		30		29		28		27		26		25	
11													
12		31		32		33		34		35		36	
13													

A. Description of original monument and accessories and/or subsequent restoration:

North Witness corner for B-3.
This position not established by original Government Surveyors

B. Description of corner evidence found and/or method applied in restoring or reestablishing corner:


North Witness corner for B-3
Set 3/4" x 36" solid bar with Ottawa County Remon cap 550.00' North of South 1/4 corner Section 6, T5N, R13W, (B-3) on East line SW 1/4 Section 6, T5N, R13W

P.A. 345 OTTAWA COUNTY
PEER APPROVED 12/1/97

C. Description of monument for corner and accessories established to perpetuate locating the position of the corner:

3/4"x36" solid rod with Ottawa County Remon cap NOTE: (see sketch on back)

Set Ottawa County Remon tag & nail East side 12" Elm AZ 165° 5.77'
Set Ottawa County Remon tag & nail East side 18" Elm AZ 15° 7.60'
Set Ottawa County Remon tag & nail North side 16" Elm AZ 235° 19.90'
Center of metal fence at highway r.o.w. AZ 180° 17.04'

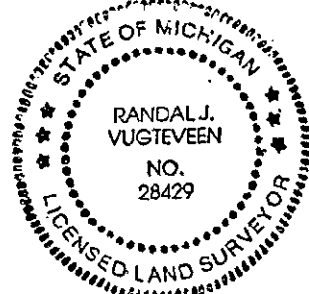


\$ 11.00 CORNER
\$ 2.00 PHOTO

Signed by

Surveyor's Michigan License No. 28429

Date DEC 1, 1997

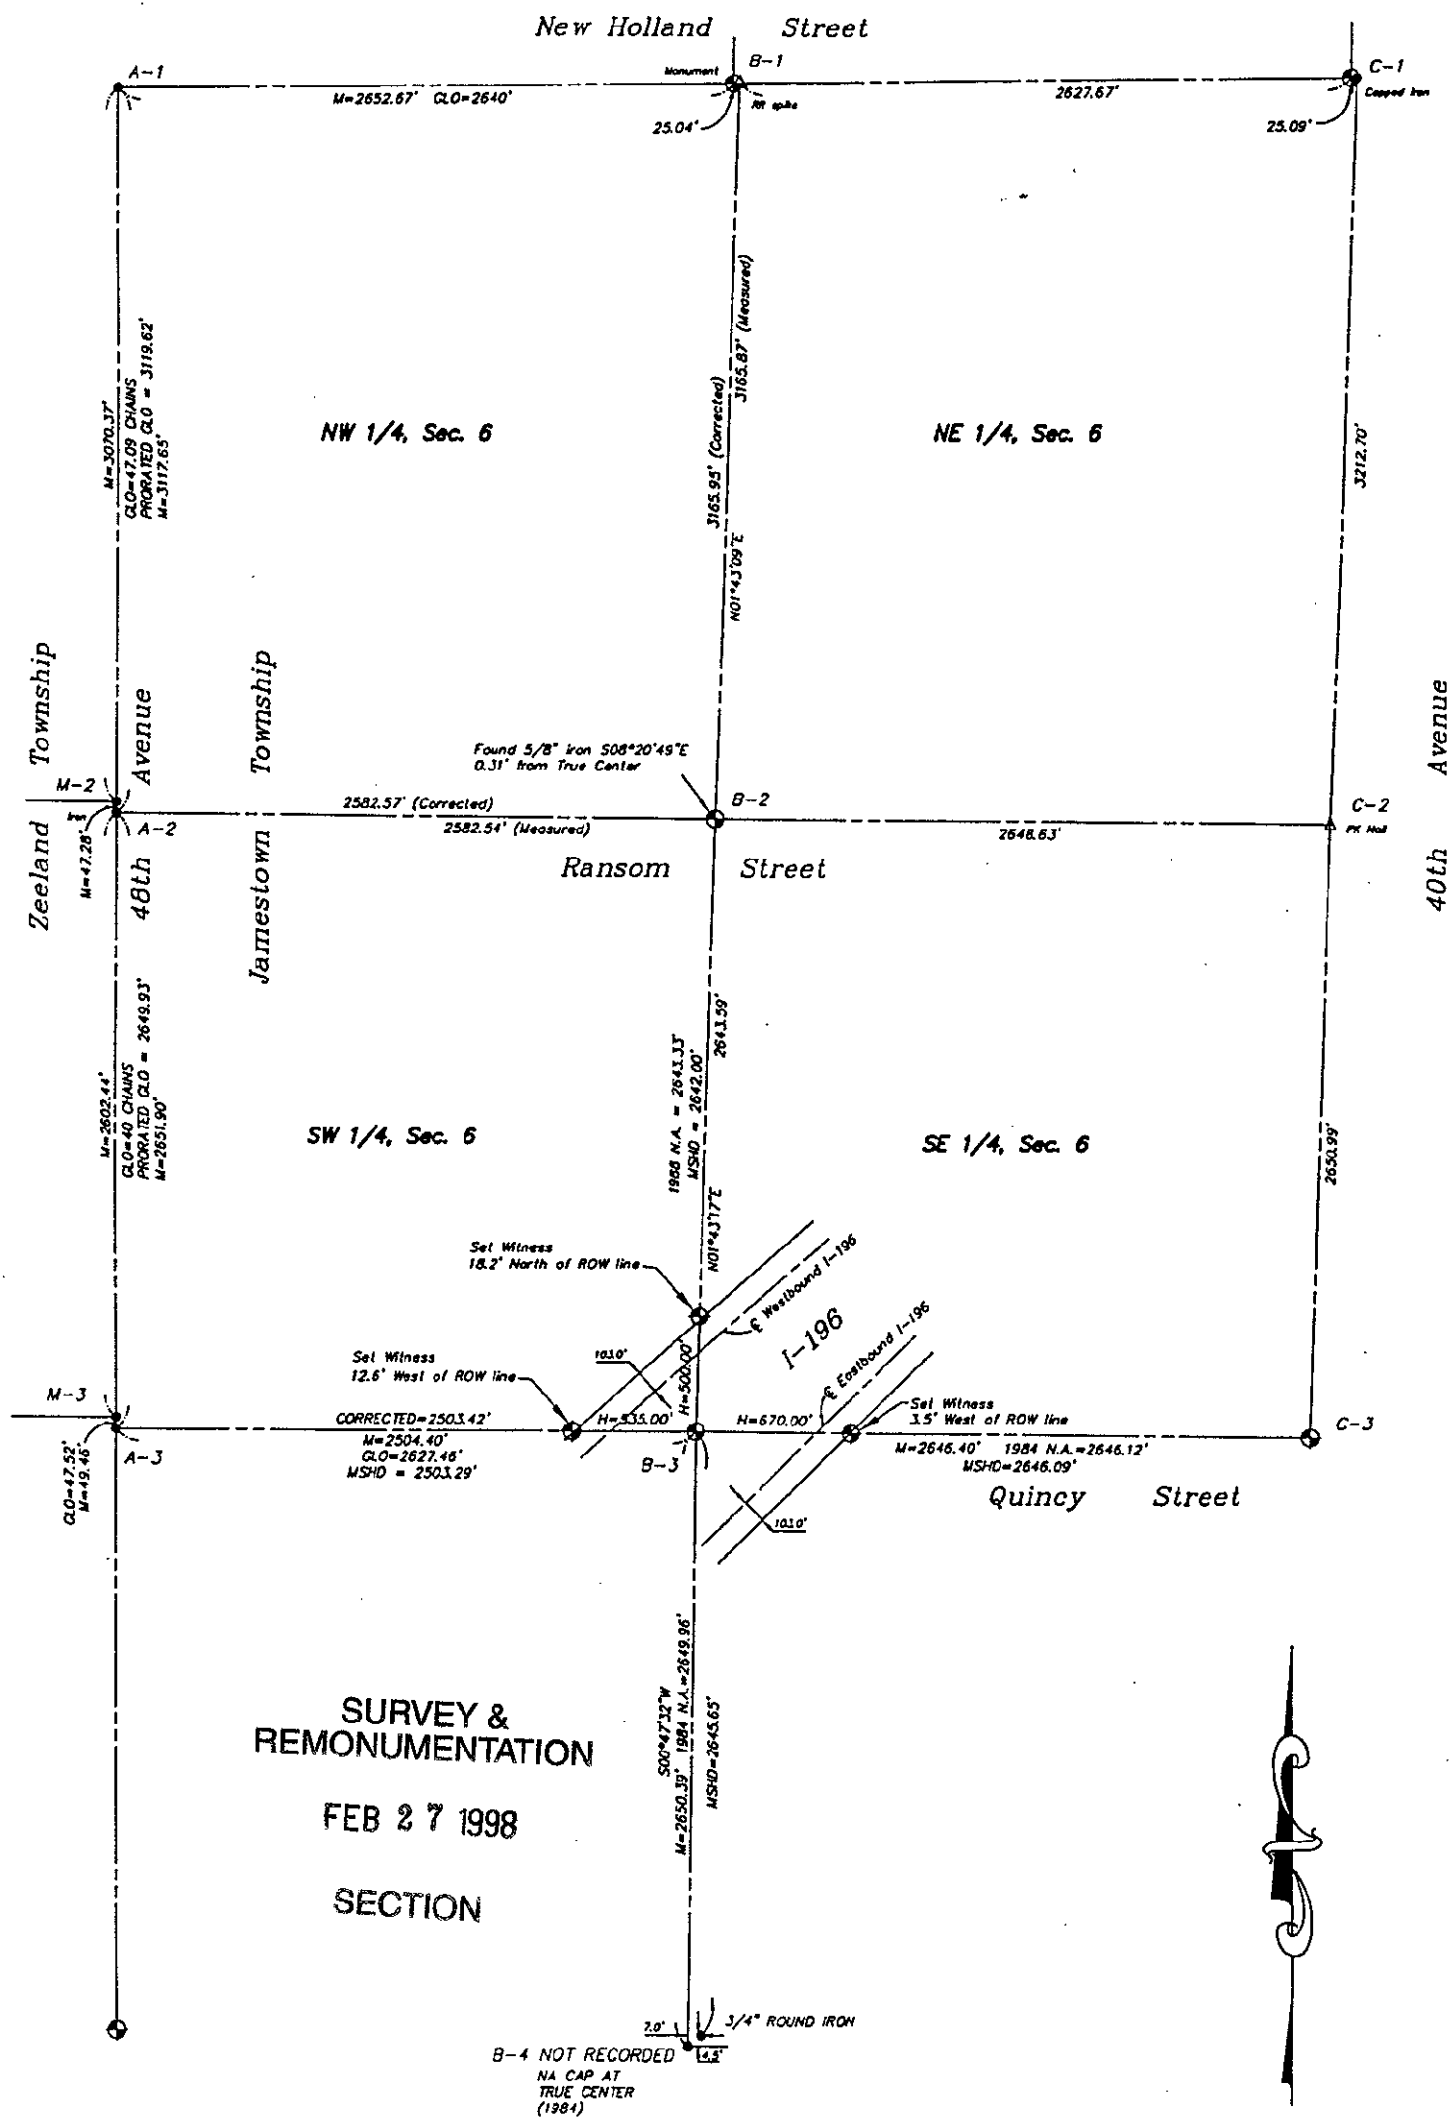

Scale: 1"=800'