

SURVEY &
REMONUMENTATION

FEB 27 1998

OTTAWA COUNTY REMONUMENTATION

SECTION

LAND CORNER RECORDATION CERTIFICATE

Filing Requirement of Act 74, Mich. P.A. 1970

For corners in

OTTAWA

(County)

Located In:

Corner Code #

1. Public Land Survey

T___ R___
T___ R___
T___ R___
T___ R___

AB-3, West witness

corner for

B-3, Jamestown

2. Property Controlling
in Section

S 6 T 5N R 13W
S 7 T 5N R 13W

Sequential
Corner #2

3. Miscellaneous
Property in Sec.

S___ T___ R___
S___ T___ R___

RECORDED

97 DEC -8 AM 11:38

Randy Schell
REGISTER OF DEEDS
OTTAWA COUNTY, MI

Register of Deeds Stamp & File Number

4. Lot No. _____, Recorded Plat _____

5. Private Claims _____

Randal J. Vugteveen

I, _____, in a field survey on November 17, 19 97 do hereby state that under requirements of P.A. 74, Michigan P.A. of 1970, the corner points mentioned in lines 1 and 2 above were in conformance with regulations and rules therefore as required in the current manual of survey instructions of the United States Department of the Interior, Bureau of Land Management or by a decree of a Court of Law and/or that the corner points mentioned in lines 3, 4 and 5 above were in conformance with the rules of the Michigan Board of Land Surveyors or by a Decree of a Court of Law; established, re-established, monumented, recovered, found as expressed below:

NOTE: Not more than 2 corners, all in the same town and range, may be recorded on this certificate.

	A	B	C	D	E	F	G	H	I	J	K	L
1												
2		6		5		4		3		2		1
3												
4		7		8		9		10		11		12
5												
6		18		17		16		15		14		13
7												
8		19		20		21		22		23		24
9												
10		30		29		28		27		26		25
11												
12		31		32		33		34		35		36
13												

A. Description of original monument and accessories and/or subsequent restoration:

West witness corner for B-3

This position not established by original Government Surveyors

B. Description of corner evidence found and/or method applied in restoring or reestablishing corner:

B-3 West witness corner for B-3

Set 3/4" x 36" solid bar with Ottawa County Remon cap 535.00' West of S 1/4 corner Section 6, T5N, R13W (B-3) on S line SW 1/4, Section 6, T5N, R13W

P.A. 345 OTTAWA COUNTY
PEER APPROVED 12/1/97

YDN

C. Description of monument for corner and accessories established to perpetuate locating the position of the corner:

B-3 West witness corner for B-3

3/4"x36" solid bar with Ottawa County Remon cap NOTE: (see sketch on back)


Set Ottawa County Remon tag & nail N side 5" Oak AZ 120° 36.57'

Set Ottawa County Remon tag & nail W side 5" Elm AZ 145° 6.75'

Set Ottawa County Remon tag & nail S side 9" Elm AZ 225° 12.66'

Set Ottawa County Remon tag & nail N side Quad Elm AZ 260° 39.85'

Wood fence corner at highway r.o.w. AZ 90° 12.50'

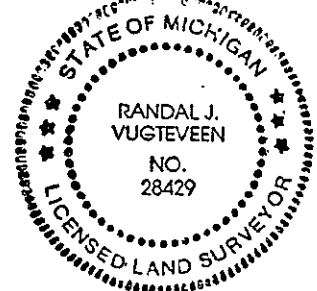

\$ 11.00 CORNER
\$ 2.00 PHOTO

Signed by

Randal J. Vugteveen

Date

Dec 1, 1997

Surveyor's Michigan License No.

28429

