

**SURVEY & REMONUMENTATION**

**FEB 27 1998**

**SECTION**

**OTTAWA COUNTY REMONUMENTATION  
LAND CORNER RECORDATION CERTIFICATE  
Filing Requirement of Act 74, Mich. P.A. 1970**

For corners in

OTTAWA

(County)

Located In:

Corner Code #

1. Public Land Survey

T \_\_\_ R \_\_\_  
T \_\_\_ R \_\_\_  
T \_\_\_ R \_\_\_  
T \_\_\_ R \_\_\_

BC-3, East witness  
corner for B-3,  
Jamestown

2. Property Controlling  
in Section

S 6 T 5N R 13W  
S 7 T 5N R 13W

Sequential  
Corner #3

3. Miscellaneous  
Property in Sec.

S \_\_\_ T \_\_\_ R \_\_\_  
S \_\_\_ T \_\_\_ R \_\_\_

**RECORDED**

**97 DEC -8 AM 11:38**

*Randy [Signature]*  
REGISTER OF DEEDS  
OTTAWA COUNTY, MI

Register of Deeds Stamp & File Number

4. Lot No. \_\_\_\_\_, Recorded Plat \_\_\_\_\_  
5. Private Claims \_\_\_\_\_

1	A	B	C	D	E	F	G	H	I	J	K	L
2		6		5		4		3		2		1
3												
4		7		8		9		10		11		12
5												
6		18		17		16		15		14		13
7												
8		19		20		21		22		23		24
9												
10		30		29		28		27		26		25
11												
12		31		32		33		34		35		36
13												

I, Randal J. Vugteveen, in a field survey on October 15, 19 97 do hereby state that under requirements of P.A. 74, Michigan P.A. of 1970, the corner points mentioned in lines 1 and 2 above were in conformance with regulations and rules therefore as required in the current manual of survey instructions of the United States Department of the Interior, Bureau of Land Management or by a decree of a Court of Law and/or that the corner points mentioned in lines 3, 4 and 5 above were in conformance with the rules of the Michigan Board of Land Surveyors or by a Decree of a Court of Law; established, re-established, monumented, recovered, found as expressed below:

NOTE: Not more than 2 corners, all in the same town and range, may be recorded on this certificate.

**A. Description of original monument and accessories and/or subsequent restoration:**

East witness corner for B-3  
This position not established by original Government Surveyors

**B. Description of corner evidence found and/or method applied in restoring or reestablishing corner:**

East witness corner for B-3  
Set 3/4" x 36" solid bar with Ottawa County Remon cap 670.00' East of South 1/4 corner Section 6, T5N, R13W, (B-3) on South line SE 1/4 Section 6, T5N, R13W


P.A. 345 OTTAWA COUNTY  
PEER APPROVED 12/1/97

*[Signature]*

**C. Description of monument for corner and accessories established to perpetuate locating the position of the corner:**

B-3 3/4" X 36" solid bar with Ottawa County Remon cap NOTE: (see sketch on back)

Set Ottawa County Remontag & nail in West side 11" Poplar AZ 53° 134.85'  
Set Ottawa County Remon tag & nail top of North guardrail post of 3 posts AZ 68° 92.67'  
Set Ottawa County Remon tag & nail in Twin 6" Poplar AZ 84° 71.77'  
NW corner house #4270 AZ 147° 224.90'  
Found capped iron on fence line AZ 270° 3.49'

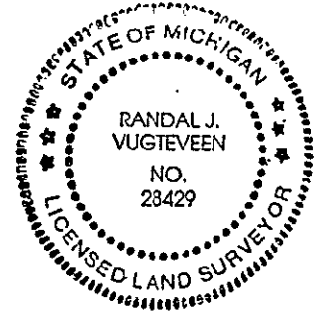

\$ 11.00 CORNER  
\$ 2.00 PHOTO

Signed by Randal J. Vugteveen  
Surveyor's Michigan License No. 28429

Date DEC 1, 1997

