

SURVEY & REMONUMENTATION

APR 25 1995

OTTAWA COUNTY REMONUMENTATION

RECORDED

COMMISSION

LAND CORNER RECORDATION CERTIFICATE

94 DEC -8 PM 12:33

Filing Requirement of Act 74, Mich. P.A. 1970

For corners in OTTAWA

Register of Deeds
REGISTER OF DEEDS
OTTAWA COUNTY, MI

Located In: Corner Code #

(County)

1. Public Land Survey

T 5N R 15W D-7 (S1/4 cor
Section 17)
Holland Twp

2. Property Controlling
in Section

S T R

3. Miscellaneous
Property in Sec.

S T R

Register of Deeds Stamp & File Number

4. Lot No. , Recorded Plat

5. Private Claims

	A	B	C	D	E	F	G	H	I	J	K	L	M
2	6	5	4	3	2	1							
3													
4	7	8	9	10	11	12							
5													
6	18	17	16	15	14	13							
7													
8	19	20	21	22	23	24							
9													
10	30	29	28	27	26	25							
11													
12	31	32	33	34	35	36							
13													

Randal J. Vugteveen

November 14

94

do hereby certify that under requirements of P.A. 74, Michigan P.A. of 1970, the corner points mentioned in lines 1 and 2 above were in conformance with regulations and rules therefore as required in the current manual of survey instructions of the United States Department of the Interior, Bureau of Land Management or by a decree of a Court of Law and/or that the corner points mentioned in lines 3, 4 and 5 above were in conformance with the rules of the Michigan Board of Land Surveyors or by a Decree of a Court of Law; established, re-established, monumented, re-monumented, recovered, found as expressed below:

NOTE: Not more than 4 corners, all in the same town and range, may be recorded on this certificate.

1. Description of original monument and accessories and/or subsequent restoration:
D-7 common corner to Sections 17 and 20

1832 - Brookfield

Set post

Maple 10" N21W 23 Links

Pepprage 10" S49W 14 Links

Liber 2, Page 25

Found Iron Pipe

Support pole NW 31.83'

St. Sign S 38.90'

Centerline Pavement S 17.0'

Liber 5, Page 67

Set 1" Steel rod in mon box with "+" on

top / NW 37.04 nail & cap N side power

pole / WSW 78.49 PK SE side of power pole

/ S 41.25' PK W side of Power pole / NE

49.30 centerline top of hydrant

3. Description of corner evidence found and/or method applied in restoring or reestablishing corner:
D-7 Found 1" solid rod in mon box 2.5' N of James Street & centerline of 132nd Avenue and accepted as a careful and faithful perpetuation of the position of the original corner

Nail & Tag #14091 N side P. pole N49W

37.07' / Top of hydrant N30E 49.37'

PA. 345 OTTAWA COUNTY
PEER APPROVED 11/21/94

Randal J. Vugteveen


C. Description of monument for corner and accessories established to perpetuate locating the position of the corner:
D-7 Removed 1" solid rod, set 3/4" X 36" solid rod with Ottawa County Remon Cap in mon box

Set Ottawa County Remon Tag & Nail in W side P. pole S12W 133.54'

Set Ottawa County Remon Tag & Nail in SW side P. pole S63E 115.66'

SW corner foundation house #2414 N41E 120.00'

Set Ottawa County Remon Tag & Nail in NE side P. pole N49W 36.95'

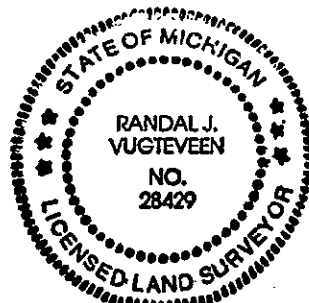

Signed by

Randal J. Vugteveen

Date

Nov. 21, 1994

Surveyor's Michigan License No.

28429