

DEC 01 1993

OTTAWA COUNTY REMONUMENTATION

RECORDED

COMMISSION

LAND CORNER RECORDATION CERTIFICATE

93 NOV 11 AM 11:53

Filing Requirement of Act 74, Mich. P.A. 1970

For corners in OTTAWA

(County)

Located In:

Corner Code #

1. Public Land Survey T 6N R 13W I-7 (SE cor
T R Section 15)
T R Georgetown Twp
T R
2. Property Controlling S T R
in Section S T R
3. Miscellaneous S T R
Property in Sec. S T R

Register of Deeds Stamp & File Number

4. Lot No. , Recorded Plat
5. Private Claims

I, Randal J. Vugteveen, in a field survey on August 4, 19 93,
do hereby certify that under requirements of P.A. 74, Michigan P.A. of 1970, the corner points mentioned
in lines 1 and 2 above were in conformance with regulations and rules therefore as required in the
current manual of survey instructions of the United States Department of the Interior, Bureau of Land
Management or by a decree of a Court of Law and/or that the corner points mentioned in lines 3, 4 and 5
above were in conformance with the rules of the Michigan Board of Land Surveyors or by a Decree of a
Court of Law; established, re-established, monumented, re-monumented, recovered, found as
expressed below:

**NOTE: Not more than 4 corners, all in the same town and range, may be recorded
on this certificate.**

A. Description of original monument and accessories and/or subsequent restoration:
I-7 Common corner to Sections 14, 15, 22 & 23

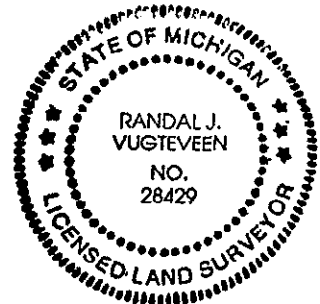
LCRC Liber 2, Page 351
Conc. Monument
Fence corner West 6.3'
T. Cable box N75W 8.9'
4" Lombardy Poplar N20W 3.8'
18" Cherry Poplar South 29.1'

B. Description of corner evidence found and/or method applied in restoring or reestablishing corner:
I-7 Found 4" square concrete mon at intersection of fences and accepted as a careful and faithful perpetuation of
the position of the original corner

Fence pose West 6.5'
T. Cable box N75W 8.9'

C. Description of monument for corner and accessories established to perpetuate locating the position of the corner:
I-7 Set Ottawa County Remon Cap on 3/4" X 3/4" solid rod

Set Ottawa County Remon Tag & Nail in S side 16" Sassafras S85W 42.89'
Set Ottawa County Remon Tag & Nail in W side 8" Maple S8E 66.15'
NW corner foundation house #1577 S67E 145.71'
NW corner foundation house #7175 S26E 136.27'

Signed by Randal J. VugteveenDate Nov. 5, 1993Surveyor's Michigan License No. 28429

FORM APPROVED BY MICHIGAN STATE BOARD OF LAND SURVEYORS, JAN. 26, 1971
REVISED MAY 14, 1975
REVISED JAN., 1983