

OCT 24 1994

COMMISSION

OTTAWA COUNTY REMONUMENTATION  
LAND CORNER RECORDATION CERTIFICATE  
Filing Requirement of Act 74, Mich. P.A. 1970

RECORDED

94 OCT -7 PM 12:33

For corners in

Ottawa  
(County)

Located In:

Corner Code #

1. Public Land Survey T 6N R 14W L-3N1/4 COR  
T R Sec. 12 Blendon  
T R  
T R
2. Property Controlling S T R  
in Section S T R
3. Miscellaneous S T R  
Property in Sec. S T R

*Robert D. Feenstra*  
REGISTER OF DEEDS  
OTTAWA COUNTY, MI.

Register of Deeds Stamp & File Number

4. Lot No. , Recorded Plat
5. Private Claims

I, Randal D. Feenstra, in a field survey on May 27, 19 94, do hereby certify that under requirements of P.A. 74, Michigan P.A. of 1970, the corner points mentioned in lines 1 and 2 above were in conformance with regulations and rules therefore as required in the current manual of survey instructions of the United States Department of the Interior, Bureau of Land Management or by a decree of a Court of Law and/or that the corner points mentioned in lines 3, 4 and 5 above were in conformance with the rules of the Michigan Board of Land Surveyors or by a Decree of a Court of Law; established, re-established, monumented, re-monumented, recovered, found as expressed below:

**NOTE:** Not more than 4 corners, all in the same town and range, may be recorded on this certificate.

A. Description of original monument and accessories and/or subsequent restoration:

LO (1838)	L-3 Page 144 (1981)
2" Sugar S20°E 9.9	1/2" x 2" Solid Bar
2" Sugar N30°E 8.6	Spike on N side 15" Ash WNW 27.05'
OST	Spike on E side 12" Ash NNW 23.45'
	Spike on E side 9" Hickory S 1.04'
amuel Marrs	Spike on N side 9" Oak ENE 17.53'

B. Description of corner evidence found and/or method applied in restoring or reestablishing corner:

Found: 1/2" x 2" Solid bar - accepted as a careful and faithful perpetuation of the position of the original corner.  
Found Witnesses:  
Nail in E side 11" Hickory S 1.04'


P.A. 345 OTTAWA COUNTY

PEER APPROVED 8/22/94

*Robert D. Feenstra*

C. Description of monument for corner and accessories established to perpetuate locating the position of the corner:

L-3 Set O.C. Remon. Bar & cap  
O.C. Remon. Nail & tag E side 8" Hickory S 0.99'  
O.C. Remon. Nail & tag E side 24" Oak N 3.96'  
O.C. Remon. Nail & tag S side 10" Hickory W 14.78'  
O.C. Remon. Nail & tag S side 30" Oak E 45.05'  
±15' West and ± 20' South of CL of Ditch

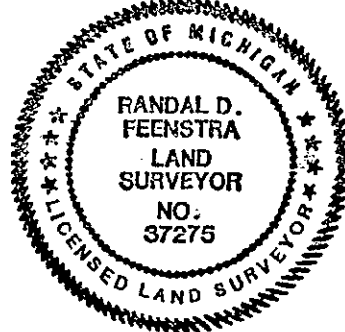

Signed by Randal D. Feenstra

Date May 27, 1994

Surveyor's Michigan License No. 37275