

OTTAWA COUNTY REMONUMENTATION  
LAND CORNER RECORDATION CERTIFICATE

RECORDED

96 DEC 18 PM 4:55

For corners in

Filing Requirement of Act 74, Mich. P.A. 1970.

REGISTER OF DEEDS  
OTTAWA COUNTY, MI

Ottawa (County)	Located in:	Corner Code #
1. Public Land Survey	T 6N R 15W	E-1
	T R	(NE cor., Sec. 5
	T R	Olive Twp.)
	T R	
	T R	
2. Property Controlling In Section	S T R	
	S T R	
3. Miscellaneous	S T R	
Property in Sec.	S T R	

Register of Deeds Stamp & File Number

4. Lot No. \_\_\_\_\_, Recorded Plat \_\_\_\_\_  
5. Private Claims \_\_\_\_\_

I, Douglas J. Koning, in a field survey on November 26, 1996, do hereby certify that under requirements of P.A. 74, Michigan P.A. of 1970, the corner points mentioned in lines 1 and 2 above were in conformance with regulations and rules therefore as required in the current manual of survey instructions of the United States Department of the Interior, Bureau of Land Management or by a decree of a Court of Law and/or that the corner points mentioned in lines 3, 4 and 5 above were in conformance with the rules of the Michigan Board of Land Surveyors or by a Decree of a Court of Law; established, re-established, monumented, re-monumented, recovered, found as expressed below:

NOTE: Not more than 4 corners, all in the same town and range, may be recorded on this certificate.

	A	B	C	D	E	F	G	H	I	J	K	L	M
2	6	5	4	3	2	1							
3													
4	7	8	9	10	11	12							
5													
6	18	17	16	15	14	13							
7													
8	19	20	21	22	23	24							
9													
10	30	29	28	27	26	25							
11													
12	31	32	33	34	35	36							
13													

A. Description of original monument and accessories and/of subsequent restoration:

E-1 Government Notes Set Post May 1832 By Calvin Britain D.S. Pine 8" S2°W 7.84 no other set North Boundary 96 West of post	L.C.R.C. Liber 3, Page 207 November 1977 E-1 Cast Iron Monument Centerline street sign ESE 49' 15" Maple SSE 60.95' 12" Quadruple Maple SW	L.C.R.C. Liber 3, Page 373 July 1979 E-1 Cast Iron Monument Support Pole NE 36.45' 20" Maple NW 58.53' Quad Maple SW 46.92' Power pole SE 117.55'
	L.C.R.C. Liber 6, Page 74 December 1990 E-1 Reset Cast Iron Monument E 63.66' to Robinson Corner NE 36.66' to Nail W side wood post SE 117.57' to Nail & Tag N side Power Pole SSE 60.90' to Nail & Cap W side 16" Maple SW 76.80' to Nail E side 16" Maple	L.C.R.C. Liber 6, Page 147 June 1991 E-1 Raised Cast Iron Monument 16" Maple SW 35.60' 14" Maple SSE 60.90' 24" Maple WSW 86.18' Fence Post NNE 36.67' Robinson Corner E 63.65'

B. Description of corner evidence found and/or method applied in restoring or reestablishing corner.

E-1 Found Cast Iron Monument in Box 0.07' North of township line.  
Found Nail & Tag #14091 in W side 18" Maple SSE 60.79'  
Found Nail & Tag in SE side Wood Post NE 36.64'  
Found Nail & Tag #14091 in N side Power Pole SE  
Found Nail E side 18" Maple SSW 76.73'  
Found Nail W side Wood Post NE 36.70'

PEER APPROVED 12-9-96

This marker is accepted as a careful and faithful perpetuation of the original corner.

C. Description of monument for corner and accessories established to perpetuate locating the position of the corner.

E-1 Established corner at the intersection of the East line of Section 5, T6N, R15W, and the South line of Section 32, T7N, R15W.


(Witnesses to point of intersection)

Cast Iron Monument in box  
Cast Iron Monument in box (E-13, T7N, R15W)  
Set Remon Tag & Nail in W side Power Pole  
Set Remon Tag & Nail in E side 18" Maple  
Set Remon Tag & Nail in S side 18" Maple  
Centerline of Top of Hydrant  
In Centerline "X" of Roads East, West And South

North 0.07'  
East 63.68'  
N31°E 32.27'  
S13°W 76.46'  
S12°E 60.62'  
N74°E 112.45'

(SEE SKETCH ON BACK)


Signed by Douglas J. Koning  
Surveyor's Michigan License No. 35995

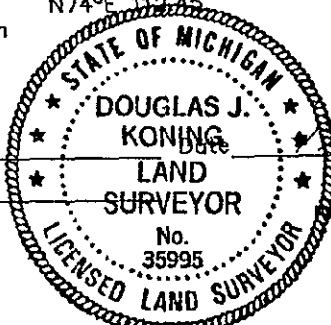

REMON LIBER 3 PAGE 365

APPROVED BY MICHIGAN STATE BOARD OF LAND SURVEYORS, JAN. 28, 1971  
REVISED MAY 14, 1975  
REVISED JAN. 1983

SECTION 32, T7N, R15W  
ROBINSON TOWNSHIP

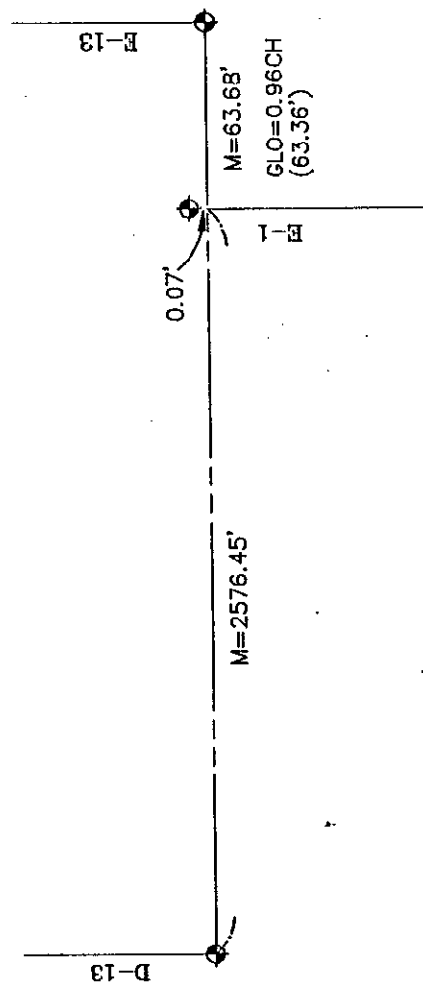

SECTION 5, T6N, R15W  
OLIVE TOWNSHIP