

SURVEY & REMONUMENTATION

DEC 01 1998

OTTAWA COUNTY REMONUMENTATION

SECTION

LAND CORNER RECORDATION CERTIFICATE Filing Requirement of Act 74, Mich. P.A. 1970

For corners in

OTTAWA

(County)

Located In:

Corner Code #

1. Public Land Survey

2. Property Controlling
in Section

3. Miscellaneous
Property in Sec.

T___R___
T___R___
T___R___
T___R___
S6 T7N R14W
S___T___R___
S___T___R___
S___T___R___

A-1-2 North Witness
for A-2 Polkton
Twp.

SEQUENTIAL
CORNER #1

RECORDED

98 SEP 29 PM 1:57

Randy M. Vugteveen
REGISTER OF DEEDS
OTTAWA COUNTY, MI

Register of Deeds Stamp & File Number

4. Lot No. _____, Recorded Plat _____
5. Private Claims _____

I, Randal J. Vugteveen, in a field survey on June 4, 1998 do hereby state that under requirements of P.A. 74, Michigan P.A. of 1970, the corner points mentioned in lines 1 and 2 above were in conformance with regulations and rules therefore as required in the current manual of survey instructions of the United States Department of the Interior, Bureau of Land Management or by a decree of a Court of Law and/or that the corner points mentioned in lines 3, 4 and 5 above were in conformance with the rules of the Michigan Board of Land Surveyors or by a Decree of a Court of Law, established, re-established, monumented, recovered, found as expressed below.

NOTE: Not more than 2 corners, all in the same town and range, may be recorded on this certificate.

	A	B	C	D	E	F	G	H	I	J	K	L	M
1													
2	6		5		4		3		2		1		
3													
4	7		8		9		10		11		12		
5													
6	10		17		16		15		14		13		
7													
8	19		20		21		22		23		24		
9													
10	30		29		28		27		26		25		
11													
12	31		32		33		34		35		36		
13													

A. Description of original monument and accessories and/or subsequent restoration:
This corner was not set by G.L.O.

B. Description of corner evidence found and/or method applied in restoring or reestablishing corner:
Held line extended South of "L" iron at the centerline of Oriole Drive and Cast Iron Monument found at NW cor Sec 6, said "L" iron referenced to Milanoski and Englert surveys dated May 29, 1979 and May 24, 1979.
This position not established by original government surveyors. This monument is accepted as the best available evidence of the position of the West line of the NW 1/4 of Section 6, T7N, R14W.

C. Description of monument for corner and accessories established to perpetuate locating the position of the corner:
A-2 Reference Monument on the North side of Grand River on the Historical West line of Sec 6

Said Monument is 96' West of straight line between A-1 & A-3
Set 3/4" X 36" Bar with Remon on top of bank
Set Nail & Remon tag in East side 16" OAK Az 209°17.47'
Set Nail & Remon tag in South side 26" OAK Az 294°86.62'
Set Nail & Remon tag in Southeast side 34" OAK Az 62°40.51'
Southeast corner House Foundation Az 345°46.01'
Old Fence line at the top of Bank +/- Az 200°10.0'
North edge of Grand River Az 180°146.0'


Signed by


Surveyor's Michigan License No.

28429

Date

SEPT. 24, 1998

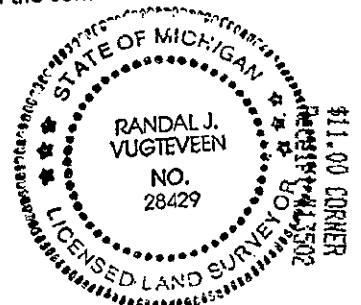

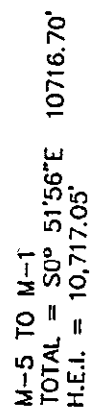

NOR.-LIN. INFORMATION FROM FIELD BOOK
#361 OTTAWA COUNTY SURVEYOR'S RECORDS
THEO. NOR. LIN. MAY 1920