

SURVEY & REMONUMENTATION

APR 05 1996

OTTAWA COUNTY REMONUMENTATION LAND CORNER RECORDATION CERTIFICATE

Commissioning Requirement of Act 74, Mich. P.A. 1970

For corners in

Robinson Twp.

Ottawa

(County)

Located In:

Corner Code ##

- | | | | | | |
|------------------------------------|---|-----|---|------|-----------|
| 1. Public Land Survey | T | 7 N | R | 15 W | E - 3 |
| | T | | R | | NW Corner |
| | T | | R | | Section 9 |
| | T | | R | | |
| 2. Property Controlling in Section | S | | T | R | |
| | S | | T | R | |
| 3. Miscellaneous Property in Sec. | S | | T | R | |
| | S | | T | R | |

RECORDED

95 NOV 29 PM 1:48

D. J. K. Kellman
REGISTER OF DEEDS
OTTAWA COUNTY, MI

Register of Deeds Stamp & File Number

4. Lot No. _____, Recorded Plat _____
5. Private Claims _____

	A	B	C	D	E	F	G	H	I	J	K	L	M
2	6		5		4		3		2		1		
3													
4	7		8		9		10		11		12		
5													
6	18		17		16		15		14		13		
7													
8	19		20		21		22		23		24		
9													
10	30		29		28		27		26		25		
11													
12	31		32		33		34		35		36		
13													

I, Carl P. Englert, Jr., in a field survey on October 16, 19 95, do hereby certify that under requirements of P.A. 74, Michigan P.A. of 1970, the corner points mentioned in lines 1 and 2 above were in conformance with regulations and rules therefore as required in the current manual of survey instructions of the United States Department of the Interior, Bureau of Land Management or by a decree of a Court of Law and/or that the corner points mentioned in lines 3, 4 and 5 above were in conformance with the rules of the Michigan Board of Land Surveyors or by a Decree of a Court of Law; established, re-established, monumented, re-monumented, recovered, found as expressed below:

NOTE: Not more than 4 corners, all in the same town and range, may be recorded on this certificate.

A. Description of original monument and accessories and/or subsequent restoration:

E - 3	Corner common to Sections 4, 5, 8 & 9.	LCRC Liber 4, Page 276
	Original corner set May, 1832.	July 10, 1981
	by Calvin Britain.	Fd Steel Bar in Mon Box
	Set Corner	10" Pine NE 55.00'
	Pine 30" N 53° W 1 ch, 11 Links	P.P. SE 89.75'
	Pine 30" S 78° E 66 Links	P.P. SSW 80.60'
		14" Oak WNW 38.36'

see other side

B. Description of corner evidence found and/or method applied in restoring or reestablishing corner:

E - 3 Corner common to Sections 4, 5, 8, & 9.
Found 3" CIM in Mon Box in CL Asphalt Road
Found 11" Pine NE 55.03'
Found P.P. SE 89.74'
Found P.P. SSW 80.63'
Found 22" Oak WNW 29.81'

P.A. 345 OTTAWA COUNTY

PEER APPROVED 11-20-95

Kendrick D. Nedrow
Y D N


Accepted as a careful and faithful perpetuation of the original position of the corner.

C. Description of monument for corner and accessories established to perpetuate locating the position of the corner:

E - 3 Corner Common to Sections 4, 5, 8, & 9.
3" CIM in Mon Box
Ottawa County Remonumentation Nail and Tag in N side 14" Pine N 52° E 55.32'
Ottawa County Remonumentation Nail and Tag in N side P.P. S 61° E 89.70'
Ottawa County Remonumentation Nail and Tag in E side P.P. S 18° W 80.56'
Ottawa County Remonumentation Nail and Tag in N side 22" Oak N 69° W 29.50'

Signed by Carl P. Englert Jr.
Surveyor's Michigan License No. 18987

Date 10/17/1995

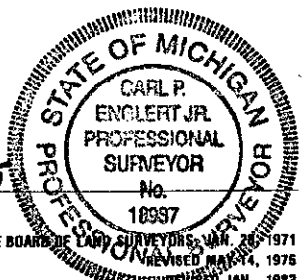

FORM APPROVED BY MICHIGAN STATE BOARD OF LAND SURVEYORS, JAN. 20, 1971
REVISED MAY 24, 1975
REVISED JAN., 1983

E - 3 LCRC Liber 5, Page 136
Fd Iron Bar in Mon Box
Set CIM
11" Pine NE 55.03'
P.P. SE 89.74'
P.P. SSW 80.63'
22" Oak WNW 29.81'

Sec 5 - 7 - 15

44-00
CORNER