

1833

COMMISSION

OTTAWA COUNTY REMONUMENTATION  
LAND CORNER RECORDATION CERTIFICATE  
Filing Requirement of Act 74, Mich. P.A. 1970

RECORDED

93 DEC 16 PM 1:00

For corners in

Ottawa  
(County)

Located In:

Corner Code ##

1. Public Land Survey T 7N R 16W G-5 N.W. corner  
T R Section 15  
T R Grand Haven Twp  
T R
2. Property Controlling S T R  
in Section S T R
3. Miscellaneous S T R  
Property in Sec. S T R

*Thomas E. Joiner*  
REGISTER OF DEEDS  
OTTAWA COUNTY, MI

Register of Deeds Stamp & File Number

4. Lot No. , Recorded Plat
5. Private Claims

I, THOMAS E. JOINER in a field survey on 11-3-, 19 93,  
do hereby certify that under requirements of P.A. 74, Michigan P.A. of 1970, the corner points mentioned  
in lines 1 and 2 above were in conformance with regulations and rules therefore as required in the  
current manual of survey instructions of the United States Department of the Interior, Bureau of Land  
Management or by a decree of a Court of Law and/or that the corner points mentioned in lines 3, 4 and 5  
above were in conformance with the rules of the Michigan Board of Land Surveyors or by a Decree of a  
Court of Law; established, re-established, monumented, re-monumented, recovered, found as  
expressed below:

**NOTE: Not more than 4 corners, all in the same town and range, may be recorded  
on this certificate.**

	A	B	C	D	E	F	G	H	I	J	K	L	M
2	6	5	4	3	2	1							
3													
4	7	8	9	10	11	12							
5													
6	18	17	16	15	14	13							
7													
8	19	20	21	22	23	24							
9													
10	30	29	28	27	26	25							
11													
12	31	32	33	34	35	36							
13													

A. Description of original monument and accessories and/or subsequent restoration:

Found IRon Pipe  
Liber 1, Pg. 505 7-13-92

Monument Box With Steel Bar  
Liber 1, Pg. 785 12-8-72


Railroad spike in 12" Maple N.W. 56.97  
12" Maple N.E. 46.09  
Power Pole S.E. 48.64  
8" Maple S.E. 67.05  
St. Sign S.E. 43.92

10" Maple N.W. 56.82  
Power Pole N.E. 48.64  
14" Maple S.E. 46.07  
10" Ash S.E. 67.04  
Power pole S.W. 95.69

B. Description of corner evidence found and/or method applied in restoring or reestablishing corner:

Found cast iron monument and accepted as a careful and faithful perpetuation of the  
position of the original corner.

10" Maple N.W. 56.82  
Power Pole N.E. 48.64

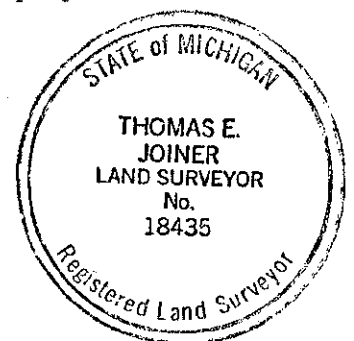

C. Description of monument for corner and accessories established to perpetuate locating the position of the corner:

Cast Iron Monument

O.C. Remon tag & nail in North side 14" Maple	N. 32° W. 57.22
O.C. Remon tag & nail in North side 9" Ash	S. 53° W. 69.43
O.C. Remon tag & nail in North side 14" White Pine	N. 47° E. 73.40
C <sub>L</sub> Hydrant	S. 34° E. 43.58

Signed by Thomas E. Joiner  
Surveyor's Michigan License No. 18435

Date 11-19-93