

SURVEY &  
REMONUMENTATION

APR 24 1995

OTTAWA COUNTY REMONUMENTATION  
LAND CORNER RECORDATION CERTIFICATE  
Filing Requirement of Act 74, Mich. P.A. 1970

RECORDED

94 DEC 15 AM 11:46

For corners in COMMISSION

OTTAWA

(County)

Located In:

Corner Code ##

1. Public Land Survey T 8N R 16W E-5, SW Corner  
T R Section 9  
T R Spring Lake Twp.  
T R
2. Property Controlling S T R  
in Section S T R
3. Miscellaneous S T R  
Property in Sec. S T R

Register of Deeds Stamp & File Number

4. Lot No. , Recorded Plat
5. Private Claims

I, THOMAS E. JOINER in a field survey on 11-21-, 19 94, do hereby certify that under requirements of P.A. 74, Michigan P.A. of 1970, the corner points mentioned in lines 1 and 2 above were in conformance with regulations and rules therefore as required in the current manual of survey instructions of the United States Department of the Interior, Bureau of Land Management or by a decree of a Court of Law and/or that the corner points mentioned in lines 3, 4 and 5 above were in conformance with the rules of the Michigan Board of Land Surveyors or by a Decree of a Court of Law, established, re-established, monumented, re-monumented, recovered, found as expressed below:

NOTE: Not more than 4 corners, all in the same town and range, may be recorded on this certificate.

A. Description of original monument and accessories and/or subsequent restoration:  
04-01-1837 Liber 5, Pg. 215, 05-21-85

Post set by John Mullet, D.S. Set Cast Iron Monument  
N49°W 17 8" Beech S. 10.36 Cor. fence post  
S19°E 34 8" Hemlock W. 20.40 5" Maple  
SE 23.61 5" Pine  
Liber 2, Pg. 249, 08-06-73 NW 22.13 Cor. fence post

Found Conc. Monument  
S. 10.46 Fence Corner  
E. 5.73 Fence post  
N. 46.78 Fence post

B. Description of corner evidence found and/or method applied in restoring or reestablishing corner:


Found Cast Iron Monument and accepted as a careful and faithful perpetuation of the position of the position of the original corner.

Liber 5, Pg. 215, 05-21-85  
West 20.40 5" Maple  
South 10.36 Cor. Fence Post  
SE 23.61 5" Pine

Liber 2, Pg. 697, 10-22-74  
SSE 10.46 Fence Cor.  
on SE Bank Drain Intersection

Liber 2, Pg. 249, 08-06-73  
South 10.46 Fence Cor.

Liber 2, Pg. 697, 10-22-74  
Found conc. monument  
SSE 10.46 Fence Corner  
E. 5.71 Fence Post  
E. 2± Fence to South  
On SE bank drain intersect

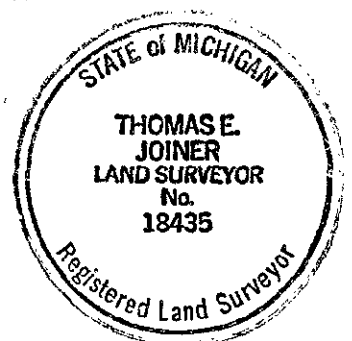

C. Description of monument for corner and accessories established to perpetuate locating the position of the corner:

Cast Iron Monument

O.C. Remon Tag & Nail in N side 6" Red Pine  
O.C. Remon Tag & Nail in NW side 8" Poplar  
O.C. Remon Tag & Nail in N side 8" Maple  
O.C. Remon Tag & Nail in SW side 12" Cherry  
Corner Lies on SE Bank of Drain Intersection

Az. 105° 9.50  
Az. 210° 20.10  
Az. 258° 20.01  
Az. 326° 16.79

P.A. 340 OTTAWA COUNTY

PEER APPROVED

Signed by

Thomas E. Joiner  
18435

Surveyor's Michigan License No.

FORM APPROVED BY MICHIGAN STATE BOARD OF LAND SURVEYORS, JAN. 28, 1971  
REVISED MAY 14, 1975  
REVISED JAN., 1983