

SURVEY &  
REMONUMENTATION

APR 24 1995

COMMISSION

OTTAWA COUNTY REMONUMENTATION  
LAND CORNER RECORDATION CERTIFICATE  
Filing Requirement of Act 74, Mich. P.A. 1970

RECORDED

94 DEC 15 AM 11:45

For corners in  
OTTAWA

(County)

Located In:

Corner Code ##

1. Public Land Survey T 8N R 16W H-11, S $\frac{1}{2}$  Corner  
T R Section 27  
T R Spring Lake Twp.  
T R  
2. Property Controlling S T R  
in Section S T R  
3. Miscellaneous S T R  
Property in Sec. S T R

*Dorothy A. Hollman*  
REGISTER OF DEEDS  
OTTAWA COUNTY, MI

Register of Deeds Stamp & File Number

4. Lot No. , Recorded Plat  
5. Private Claims

I, THOMAS E. JOINER, in a field survey on 11-29-, 19 94, do hereby certify that under requirements of P.A. 74, Michigan P.A. of 1970, the corner points mentioned in lines 1 and 2 above were in conformance with regulations and rules therefore as required in the current manual of survey instructions of the United States Department of the Interior, Bureau of Land Management or by a decree of a Court of Law and/or that the corner points mentioned in lines 3, 4 and 5 above were in conformance with the rules of the Michigan Board of Land Surveyors or by a Decree of a Court of Law; established, re-established, monumented, re-monumented, recovered, found as expressed below:

NOTE: Not more than 4 corners, all in the same town and range, may be recorded on this certificate.

A. Description of original monument and accessories and/or subsequent restoration:

05-26-1832 Liber 1, Pg. 653, 10-13-72  
Post set by John Mullet, D.S. Found 1 $\frac{1}{2}$ " Bolt head  
N16°E 36 24" White Oak SW 23.78 Support Pole  
S46°E 34 25" White Oak NW 36.52 Power Pole  
NW 46.12  $\emptyset$  Hydrant  
SE 29.75 12" D.B.H. Oak  
SE 30.90 Street Sign


B. Description of corner evidence found and/or method applied in restoring or reestablishing corner:

Found PK & Washer 0.2' from manhole rim and accepted as a careful and faithful perpetuation of the position of the original corner.

Liber 1, Pg. 653, 10-13-72  
NW 36.52 Power Pole  
NW 46.12  $\emptyset$  Hydrant

P.A. 345 OTTAWA COUNTY  
PEER APPROVED 12/12/94

*Madison D. Nedwell*

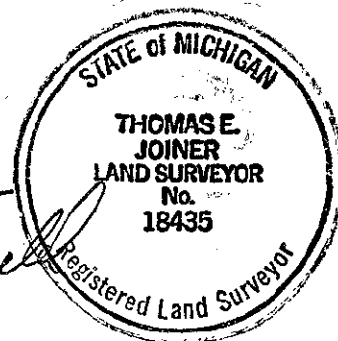

C. Description of monument for corner and accessories established to perpetuate locating the position of the corner:

Replaced PK and Washer with 1/2" Rebar with Steel Cap inscribed "Ottawa County Remonumentation Survey Marker PS 21272"

$\emptyset$ Top Operating Nut on Hydrant	Az. 52°	48.45
O.C. Remon. Tag & Nail in NE Side 22" Oak	Az. 141°	43.85
O.C. Remon. Tag & Nail in N Side 15" Oak	Az. 250°	83.38
$\emptyset$ Top Operating Nut on hydrant	Az. 328°	46.14
$\emptyset$ Manhole	Az. 135°	1.3

Signed by Thomas E. Joiner  
Surveyor's Michigan License No. 18435

Date 12-12-94