

SURVEY & REMONUMENTATION

FEB 27 1998

**OTTAWA COUNTY REMONUMENTATION
LAND CORNER RECORDATION CERTIFICATE**
Filing Requirement of Act 74, Mich. P.A. 1970

SECTION

For corners in Ottawa (County) Located In: _____ Corner Code # _____

1. Public Land Survey T8N R16W G-6, 7,
T R
T R
T R
East 1/4 corner
Section 16

2. Property Controlling S15 T8N R16W Reference _____
in Section S16 T8N R16W Monument _____

3. Miscellaneous S T R
Property in Sec. S T R
SEQUENTIAL
COVER #5

4. Lot No. _____, Recorded Plat _____

5. Private Claims _____

RECORDED

97 DEC -8 AM 11:32

Sam Scholtz
REGISTER OF DEEDS
OTTAWA COUNTY, MI

Register of Deeds Stamp & File Number

	A	B	C	D	E	F	G	H	I	J	K	L
1												
2	6	5			4			3		2		1
3												
4	7	8			9			10		11		12
5												
6	18	17			16			15		14		13
7												
8	19	20			21			22		23		24
9												
10	30	29			28			27		26		25
11												
12	31	32			33			34		35		36
13												

I, Steve Lampen, in a field survey on December 1 19 97, do hereby certify that under requirements of P.A. 74, Michigan P.A. of 1970, the corner points mentioned in lines 1 and 2 above were in conformance with regulations and rules therefore as required in the current manual of survey instructions of the United States Department of the Interior, Bureau of Land Management or by a decree of a Court of Law and/or that the corner points mentioned in lines 3, 4 and 5 above were in conformance with the rules of the Michigan Board of Land Surveyors or by a Decree of a Court of Law, established, re-established, monumented, re-monumented, recovered, found as expressed below:

NOTE: Not more than 4 corners, all in the same town and range, may be recorded on this certificate.

A. Description of original monument and accessories and/or subsequent restoration:

G-6
G.L.O. Brookfield 1832
North between Sections 15 and 16
2.40 over river and set post
28.25 Bayou set post South side
52.00 leave Bayou and set South side
59.70 W. Oak 6 South side Bay
72.19 W. Oak 30 North side of Bay
80.00 set post corner Sections 9, 10, 15 and 16

Section line between Sections 15 and 16 is shown on plats of:
Millpoint 1849
Barber's Addition - 1852
Streng and Gilleland's Subdivision - 1911

B. Description of corner evidence found and/or method applied in restoring or reestablishing corner:

G-6
G-6 was not monumented in the original GLO Survey. Calculated North and South position mid-way between G-5 and G-7. Re-established Section line between Sections 15 and 16 by plat listed in Part A.

Set Ottawa County remonumentation iron and cap on the section line between Section 15 and 16 at the GLO meander post position. G-6 not monumented in the original GLO survey. Calculated position of G-6 is accepted as the best position of the corner.

See sketch on back


P.A. 345 OTTAWA COUNTY
PEER APPROVED 12-1-97

YD 71

C. Description of monument for corner and accessories established to perpetuate locating the position of the corner:


G-6 Reference monument - Ottawa County Remonumentation iron and cap on the section line between sections 15 and 16 at the GLO meander post location.

North and South chain link fence	270°		1.0'
SW corner building, brick	147°	54'	15.3'
NE corner House foundation	243°	05'	69.23'
NE corner concrete wall	285°	07'	83.85'
NE corner steel seawall, inside corner	336°	35'	48.33'
South Shore Spring Lake	2°		47'±
G-6	1°	58' 43"	781.13'
G-7	181°	03' 34"	1878.2'

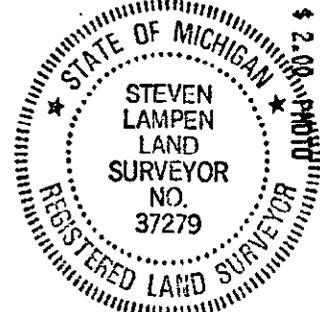


Signed by Steven Lampen Date DECEMBER 1, 1997

Surveyor's Michigan License No. 37279

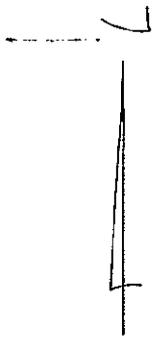

G-5, T8N R16W

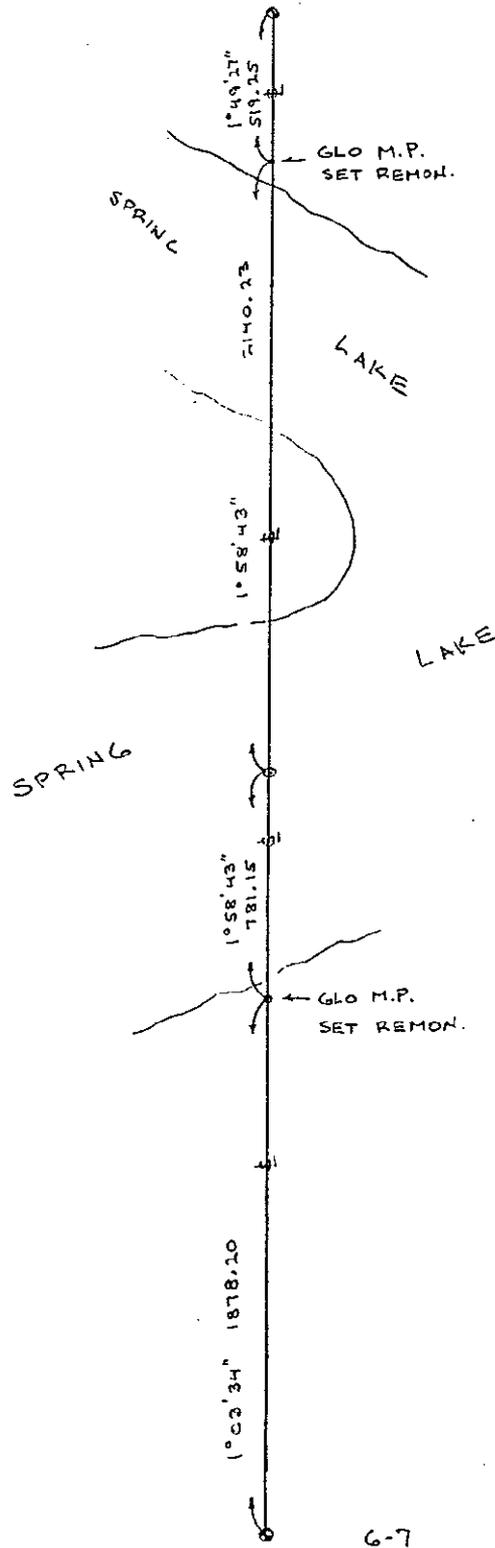

SECTION
16

SECTION
15

SURVEY &
REMONUMENTATION

FEB 27 1998

SECTION