

SURVEY & REMONUMENTATION

FEB 27 1998

**OTTAWA COUNTY REMONUMENTATION
LAND CORNER RECORDATION CERTIFICATE
Filing Requirement of Act 74, Mich. P.A. 1970**

For corners in
Ottawa Located In: Corner Code #
(County)

1. Public Land Survey T8N R16W E, F-7, W
T R Northwest corner
T R Section 21
T R Reference monument

2. Property Controlling S 16 T 8N R 16W SEQUENTIAL
in Section S 21 T 8N R 16W CORNER # 10

3. Miscellaneous S T R
Property in Sec. S T R

RECORDED
97 DEC -8 AM 11:32
Sam [Signature]
REGISTER OF DEEDS
OTTAWA COUNTY, MI
Register of Deeds Stamp & File Number

4. Lot No. _____, Recorded Plat _____
5. Private Claims _____

| | | | | | | | | | | | | | |
|----|----|----|----|----|----|----|---|---|---|---|---|---|---|
| 1 | A | B | C | D | E | F | G | H | I | J | K | L | M |
| 2 | 6 | 5 | 4 | 3 | 2 | 1 | | | | | | | |
| 3 | | | | | | | | | | | | | |
| 4 | 7 | 8 | 9 | 10 | 11 | 12 | | | | | | | |
| 5 | | | | | | | | | | | | | |
| 6 | 18 | 17 | 16 | 15 | 14 | 13 | | | | | | | |
| 7 | | | | | | | | | | | | | |
| 8 | 19 | 20 | 21 | 22 | 23 | 24 | | | | | | | |
| 9 | | | | | | | | | | | | | |
| 10 | 30 | 29 | 28 | 27 | 26 | 25 | | | | | | | |
| 11 | | | | | | | | | | | | | |
| 12 | 31 | 32 | 33 | 34 | 35 | 36 | | | | | | | |
| 13 | | | | | | | | | | | | | |

I, Steve Lampen, in a field survey on December 1, 1997, do hereby certify that under requirements of P.A. 74, Michigan P.A. of 1970, the corner points mentioned in lines 1 and 2 above were in conformance with regulations and rules therefore as required in the current manual of survey instructions of the United States Department of the Interior, Bureau of Land Management or by a decree of a Court of Law and/or that the corner points mentioned in lines 3, 4 and 5 above were in conformance with the rules of the Michigan Board of Land Surveyors or by a Decree of a Court of Law; established, re-established, monumented, re-monumented, recovered, found as expressed below:

NOTE: Not more than 4 corners, all in the same town and range, may be recorded on this certificate.

A. Description of original monument and accessories and/or subsequent restoration:

E-7
G.L.O. - Brookfield - 1837
55.00 old post left bank river
80.00 over to marshy island set post corner to Sections 16, 17, 20 and 21 on margin of marsh. No trees.

E-7 is shown on Plat of Storrs and Co. - 1869 and Survey by Englert No. 18987 - 1972. E-7 and Section lines are shown on Survey by Bowen - 1935, Survey of Harbor Island - 1936, Triangulation Survey - 1959

B. Description of corner evidence found and/or method applied in restoring or reestablishing corner:

E-7
Found large pipe iron lying down in water at E-7. Re-established E-7 by found monumentation of Englert Survey. Position of E-7 fits reasonably well with Bowen Survey of 1935. Large pipe is reported to have been used by R. V. Terril - Re-Triangulation Survey of 1959. Pipe has been used in Surveys on the railroad in 1970's. Pipe was also used for Surveys by David Greer - No. 16042 in late 1960's. Found no monumentation of section line between Sections 16 and 21 from surveys. Found no survey record that the original G.L.O. meander post between Sections 16 and 21 had ever been found. Set Ottawa County Remonumentation iron and cap on the section line between E-7 and G-7 as a reference monument for E-7. The position of E-7 is accepted a careful and faithful perpetuation of the position of the original corner.


See sketch on back.

P.A. 345 OTTAWA COUNTY
PEER APPROVED 12-1-97
[Signature]

C. Description of monument for corner and accessories established to perpetuate locating the position of the corner:

E-7 Reference monument - Ottawa County Remonumentation iron and cap on the section line between Sections 16 and 21.

| | | |
|--|--------------|----------|
| Remonumentation tag on East side 40" Willow | 350° | 2.63' |
| Remonumentation tag on Southeast side power pole | 120° | 64.00' |
| Remonumentation tag on East side 48" Willow | 181° | 53.87' |
| Remonumentation tag on South side 10" Poplar | 282° | 12.40' |
| Centerline North and South road pavement | 90° | 39.00' |
| E-7 | 268° 17' 53" | 70.00' |
| F-7 | 88° 17' 53" | 2647.90' |
| G-7 | 88° 17' 53" | 5365.80' |

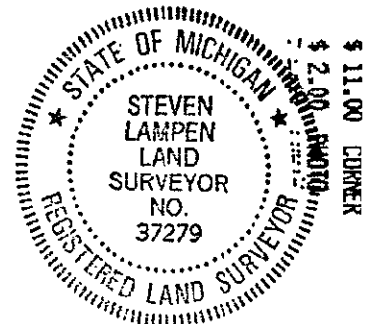


Signed by Steven Lampen Date DECEMBER 1, 1997
Surveyor's Michigan License No. 37279

E-7
T&H
R16W

SET
REFERENCE
REMON.

F-7

G-7

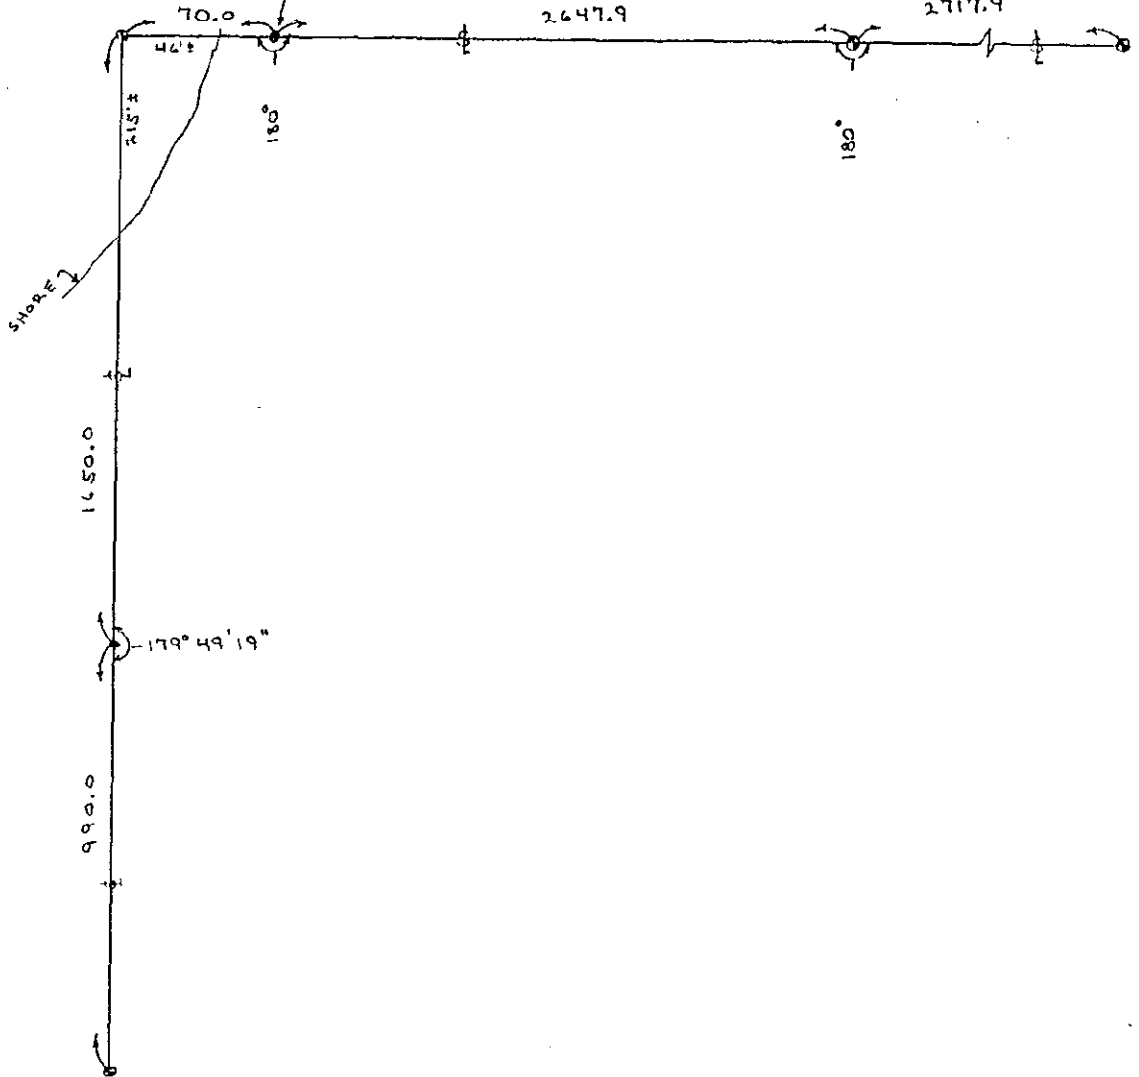

**SURVEY &
REMONUMENTATION**

FEB 27 1998

SECTION