

SURVEY & REMONUMENTATION

DEC 01 1998

SECTION

OTTAWA COUNTY REMONUMENTATION LAND CORNER RECORDATION CERTIFICATE Filing Requirement of Act 74, Mich. P.A. 1970

For corners in

<u>Ottawa</u> (County)	Located In:	Corner Code #
	<u>SPRING LAKE TWP.</u>	
1. Public Land Survey	T8N R16W	I-6, 7
	T R	
	T R	
	T R	
2. Property Controlling in Section	S15 T8N R16W	South witness corner to I-6
	S T R	
3. Miscellaneous Property in Sec.	S T R	
	S T R	

RECORDED
98 JUL 24 PM 1:47

Harry Sullivan
REGISTER OF DEEDS
OTTAWA COUNTY, MI

Register of Deeds Stamp & File Number

4. Lot No. _____, Recorded Plat _____
5. Private Claims _____

I, Steve Lampen, in a field survey on April 19 98, do hereby certify that under requirements of P.A. 74, Michigan P.A. of 1970, the corner points mentioned in lines 1 and 2 above were in conformance with regulations and rules therefore as required in the current manual of survey instructions of the United States Department of the Interior, Bureau of Land Management or by a decree of a Court of Law and/or that the corner points mentioned in lines 3, 4 and 5 above were in conformance with the rules of the Michigan Board of Land Surveyors or by a Decree of a Court of Law; established, re-established, monumented, re-monumented, recovered, found as expressed below:

NOTE: Not more than 4 corners, all in the same town and range, may be recorded on this certificate.

A. Description of original monument and accessories and/or subsequent restoration:
I-6

GLO - Mullett - 1837
North between Sections 14 and 15
20.04 B. Oak 10
37.85 Pine 24" on margin of Bayou
80.00 Corner Sections 10, 11, 14, 15
in Bayou

Section line between Sections 14 and 15 is shown on the Plats of Spring Lake Beach - 1901
Resubdivision of Buena Vista - 1924

B. Description of corner evidence found and/or method applied in restoring or reestablishing corner:
I-6
I-6 was not monumented in the original GLO survey.

Calculated North and South position of I-6 and the GLO MP - Pine by proportionate measure between I-5 and I-7.

Calculated the East and West location of the Section line between Sections 14 and 15 from the Plats in Part A to set the GLO MP. Calculated I-6 on line between the GLO MP and I-5.

Set an Ottawa County Remonumentation iron and cap at the GLO Meander post position. I-6 was not monumented in the original GLO survey. Calculated position of I-6 is accepted as the best position of the corner.

See sketch on back.

C. Description of monument for corner and accessories established to perpetuate locating the position of the corner:

I-6 Reference Monument -
Ottawa County Remonumentation iron and cap at the GLO Meander post position - Azimuth = Michigan State Plane Grid direction.

Power pole, nail NE side	315° 55'	35.17
SE corner bldg, concrete block, 7' high	220° 06'	57.89
Hydrant, top, centerline	171° 20'	111.55
SW corner house, wood siding	20° 54'	104.42
Power pole, pk in south side	79° 16'	18.29
South shore Spring Lake	2°	122 ±
I-7	181° 08'	2509.10
I-6	1° 59'	142.52

Signed by Steven Lampen
Surveyor's Michigan License No. 37279


Date JULY 20, 1998

FORM APPROVED BY MICHIGAN STATE BOARD OF LAND SURVEYORS, MAY 28, 1971

REVISED MAY 14, 1975
REVISED JAN., 1983
ADAPTED FOR WORD PROCESSING MARCH, 1993

	A	B	C	D	E	F	G	H	I	J	K	L	M
2	6	5	4	3	2	1							
3													
4	7	8	9	10	11	12							
5													
6	18	17	16	15	14	13							
7													
8	19	20	21	22	23	24							
9													
10	30	29	28	27	26	25							
11													
12	31	32	33	34	35	36							
13													

PLAT APPROVED 6-15-98
H.D.T.

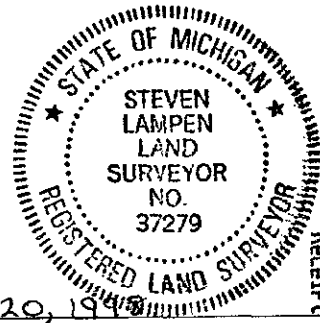

Receipt #0101
\$11.00 FEE

SURVEY &
REMONUMENTATION

DEC 01 1998

SECTION

RESUBDIVISION
OF BUENA
VISTA PLAT

BUENA
VISTA
R.O.

