

RECEIVED
FEB 24 2000

RECORDED

OTTAWA COUNTY REMONUMENTATION

99 JUL 30 PM 12: 26

LAND CORNER RECORDATION CERTIFICATE
Filing Requirement of Act 74, Mich. P.A. 1970

For corners in SECTION

Sam Schell
REGISTER OF DEEDS
OTTAWA COUNTY, MI

Located In: Corner Code #
Chester Twp. A-9 NW Cor.
9N 13W
T R Sec. 30
T R
T R
T R
S T R
S T R
S T R
S T R

1. Public Land Survey

2. Property Controlling
in Section

3. Miscellaneous
Property in Sec.

4. Lot No. , Recorded Plat
5. Private Claims

Register of Deeds Stamp & File Number

I, Randal D. Feenstra, in a field survey on March 15, 1999 do hereby state that under requirements of P.A. 74, Michigan P.A. of 1970, the corner points mentioned in lines 1 and 2 above were in conformance with regulations and rules therefore as required in the current manual of survey instructions of the United States Department of the Interior, Bureau of Land Management or by a decree of a Court of Law and/or that the corner points mentioned in lines 3, 4 and 5 above were in conformance with the rules of the Michigan Board of Land Surveyors or by a Decree of a Court of Law; established, re-established, monumented, recovered, found as expressed below:

NOTE: Not more than 2 corners, all in the same town and range, may be recorded on this certificate.

	A	B	C	D	E	F	G	H	I	J	K	L	M
1													
2	6		5		4		3		2		1		
3													
4	7		8		9		10		11		12		
5													
6	18		17		16		15		14		13		
7													
8	19		20		21		22		23		24		
9													
10	30		29		28		27		26		25		
11													
12	31		32		33		34		35		36		
13													

A. Description of original monument and accessories and/or subsequent restoration:

G.L.O. Sept. 17, 1838

Rasselus Whitcomb

Set Post

12" Lyme S28°E 32 Links

6" Beech N26°E 19 Links

L-5 P-8 1982 (Joiner)

Part B: Found Iron Bar
(No ties)

Part C: Cast Iron Monument

Tel. Pole SW 33.85

End bolt on bridge NW 21.57

End bolt on bridge NNW 42.47

End bolt on bridge 21.95

(Continued on other side)

B. Description of corner evidence found and/or method applied in restoring or reestablishing corner:

A-9 Found: Cast Iron Monument in Gravel

Found bolt on bridge NW 21.55'

Found bolt on bridge NNW 42.45'

Found bolt on bridge NE 21.91'

P.A. 345 OTTAWA COUNTY

PEER APPROVED 7/12/99

Accepted as a careful and faithful perpetuation of the position of the original corner.

C. Description of monument for corner and accessories established to perpetuate locating the position of the corner:

A-9 Cast Iron Monument in gravel


Set Ottawa County Remon Tag & Nail in S end bridge AZ 50°55' 21.92'

Set Ottawa County Remon Tag & Nail in NW side P. Pole AZ 233°0' 33.64'

Set Ottawa County Remon Tag & Nail in S end bridge AZ 310°35' 21.50'

Set Ottawa County Remon Tag & Nail in NE side P. Pole AZ 339°25' 77.75'

On centerline N-S gravel Rd. (48th Ave.)

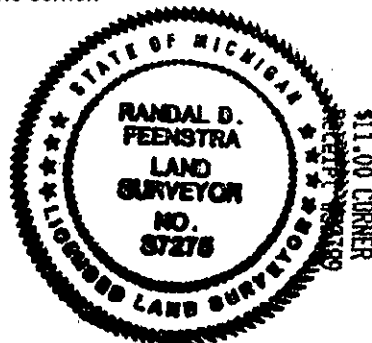

Signed by Randal D. Feenstra
Surveyor's Michigan License No. 37275

Date May, 14, 1999

Muskegon County Information
M-9 L-301, P-602 1984 (Lewandoski)
Cast Iron Monument
30" Oak N33°W 66.8'
16" Tw. Willow S35°W 63.20'
Power Pole N83°E 76.78'

SURVEY &
RECORDS

FEB 24 2000

SECTION

