

# LAND CORNER RECORDATION CERTIFICATE

Filing Requirement of Act 74, Mich. P.A. 1970

For corners in

ONTONAGON

(County)

GOEBIC

Located In:

Corner Code #

1. Public Land Survey

T48N R41W

C-13

T47N R41W

C-1

T R

T R

2. Property Controlling  
In Section

S

T R

S

T R

3. Miscellaneous  
Property in Sec.

S

T R

S

T R

SURVEY &  
REMONUMENTATION

MAR 23 2000

SECTION

Register of Deeds Stamp &amp; File Number

4. Lot No. \_\_\_\_\_, Recorded Plat \_\_\_\_\_

5. Private Claims \_\_\_\_\_

Section Corner common to Sections 31 & 32, T48N R41W and  
Sections 5 & 6, T47N R41W.

I, Earl W. Applekamp, in a field survey on Sept. 29, 1999 do hereby state that under requirements of P.A. 74, Michigan P.A. of 1970, the corner points mentioned in lines 1 and 2 above were in conformance with regulations and rules therefore as required in the current manual of survey instructions of the United States Department of the Interior, Bureau of Land Management or by a decree of a Court of Law and/or that the corner points mentioned in lines 3, 4 and 5 above were in conformance with the rules of the Michigan Board of Land Surveyors or by a Decree of a Court of Law; established, re-established, monumented, recovered, found as expressed below:

NOTE: Not more than 2 corners, all in the same town and range, may be recorded on this certificate.

A. Description of original monument and accessories and/or subsequent restoration:

Original corner established by William A. Burt, U.S. Deputy Surveyor, 1847. Set Cedar Post.

ORIGINAL BEARING TREES:

Hemlock 16" N59°E 39 Links (25.74 feet)  
Tamarack 24" N67°W 40 Links (26.40 feet)

DEER GROUP APPROVED

Earl W. Applekamp  
COUNTY REPRESENTATIVE

10-14-99

B. Description of corner evidence found and/or method applied in restoring or reestablishing corner:


No original evidence was found. A 4"x4" yellow tag on an aspen indicating approximate corner 15 feet South. This position is East about 30 feet from the position I ultimately set the corner. I re-established the corner by single proportionate measure and on the Town line between the monumented SW Corner of Section 31 and the S $\frac{1}{4}$  Corner of Section 32. These two corners had been monumented from original bearing trees in 1961 & 1970 respectively. This position is consistent with a GLO call of "79 Chains Enter Swamp."

Research on file with the Ontonagon County Remonumentation Program Representative.

C. Description of monument for corner and accessories established to perpetuate locating the position of the corner:

At the corner position I set a 2 $\frac{1}{2}$ "x30" split base aluminum pipe with a 3" cap stamped to read: County Remonumentation, T48N T47N R41W, S31, S32, S5, S6, P.S. 17610. I established three bearing trees and a reference object.

Nail in 4" Balsam S36°W 33.35' - Nail in 5" Balsam S31°E 33.30'  
Nail in 6" Aspen N87°E 31.35' - 6' Steel Sign Post North 0.83'

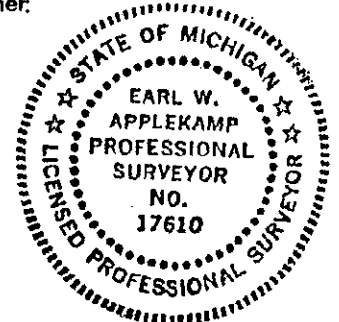

Signed by Earl W. Applekamp  
Surveyor's Michigan License No. 17610

Date October 1, 1999