

LAND CORNER RECORDATION CERTIFICATE
 Filing Requirement of Act 74, Mich. P.A. 1970

For corners in


<u>ONTONAGON</u> (County)	Located In:	Corner Code #
1. Public Land Survey	T48N R 41W	J-5
	T ___ R ___	_____
	T ___ R ___	_____
	T ___ R ___	_____
2. Property Controlling in Section	S ___ T ___ R ___	_____
	S ___ T ___ R ___	_____
3. Miscellaneous Property in Sec.	S ___ T ___ R ___	_____
	S ___ T ___ R ___	_____

SURVEY'S
 RE-MONUMENTATION
 JAN 11 1999
 SECTION
 Register of Deeds Stamp & File Number

4. Lot No. _____, Recorded Plat _____
 5. Private Claims _____

$\frac{1}{4}$ Corner common to Sections 11 & 14, T48N R41W.

I, Earl W. Applekamp, in a field survey on June 25, 1998 do hereby state that under requirements of P.A. 74, Michigan P.A. of 1970, the corner points mentioned in lines 1 and 2 above were in conformance with regulations and rules therefore as required in the current manual of survey instructions of the United States Department of the Interior, Bureau of Land Management or by a decree of a Court of Law and /or that the corner points mentioned in lines 3, 4 and 5 above were in conformance with the rules of the Michigan Board of Land Surveyors or by a Decree of a Court of Law; established, re-established, monumented, recovered, found as expressed below:

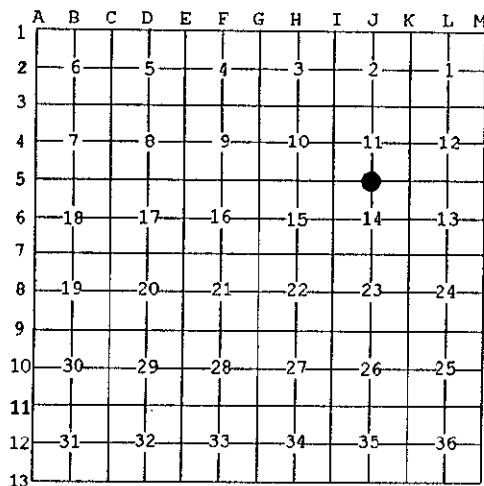

NOTE: Not more than 2 corners, all in the same town and range, may be recorded on this certificate.

A. Description of original monument and accessories and/or subsequent restoration:

Original Corner established by Wells Burt, U.S. Deputy Surveyor, June 20, 1851. Set Wood Post.

ORIGINAL BEARING TREES:

16" Cedar S62°E 11.22 feet
 20" Cedar S15°W 5.94 feet

PEER GROUP APPROVED
Earl W. Applekamp
 COUNTY REGISTERED 7-22-98

B. Description of corner evidence found and/or method applied in restoring or reestablishing corner:

No original evidence was found. Corner position falls in a North-South County Road (Norwich Road), which has been in existence since the early 1900's. At the calculated position there was a paint line for logging East and a downed fence line running West. I re-established the corner in the centerline of the road and on line between opposite section corners East and West.

Research on file with the Ontonagon County Remonumentation Program Representative.

C. Description of monument for corner and accessories established to perpetuate locating the position of the corner:

At the corner position I set a 5/8"X12" rebar with a 3" stamped cap 2 1/2" below top of blacktop and in the centerline of the road. Cap is stamped to read: County Remonumentation, T48N R41W, $\frac{1}{4}$, S11, S14, 1998, P.S. 17610 I established a reference monument, a 2 1/2"X30" split base aluminum pipe with a 3" cap stamped as above. I also established 3 bearing trees.

REF. MON. N89°-07'-38"W 49.32' - Nail in 11" Maple N46°E 77.06'
 Nail in 7" Maple N70°W 58.68' - Nail in 10" Basswood S89°E 47.49'



Signed by Earl W. Applekamp
 Surveyor's Michigan License No. 17610

Date July 15, 1998