

SURVEY & REMONUMENTATION

APR 25 1995

COMMISSION

LAND CORNER RECORDATION CERTIFICATE Filing Requirement of Act 74, Mich. P.A. 1970

For corners in

Ontonagon
(County)

Located In:

Corner Code #

- | | | |
|------------------------------------|-------------------------|---------|
| 1. Public Land Survey | T 48N R 42W | E-F-13 |
| | T _____ R _____ | _____ |
| | T _____ R _____ | _____ |
| | T _____ R _____ | _____ |
| | T _____ R _____ | #1 p.m. |
| 2. Property Controlling in Section | S _____ T _____ R _____ | _____ |
| | S _____ T _____ R _____ | _____ |
| 3. Miscellaneous Property in Sec. | S _____ T _____ R _____ | _____ |
| | S _____ T _____ R _____ | _____ |

Recorded December 7 1994
at 4:15 o'clock P. M. in
Liber 3 page 230
Jessie M. Marley deputy
Register of Deeds

Register of Deeds Stamp & File Number

4. Lot No. _____, Recorded Plat _____
5. Private Claims _____

Meander corner common to Section 33, T48N, R42W and Section 4, T47N, R42W.

I, John R. Garske, in a field survey on October 22, 19 94, do hereby certify that under requirements of P.A. 74, Michigan P.A. of 1970, the corner points mentioned in lines 1 and 2 above were in conformance with regulations and rules therefore as required in the current manual of survey instructions of the United States Department of the Interior, Bureau of Land Management or by a decree of a Court of Law and/or that the corner points mentioned in lines 3, 4 and 5 above were in conformance with the rules of the Michigan Board of Land Surveyors or by a Decree of a Court of Law; established, re-established, monumented, re-monumented, recovered, found as expressed below:

NOTE: Not more than 4 corners, all in the same town and range, may be recorded on this certificate.

	A	B	C	D	E	F	G	H	I	J	K	L	M
2	6		5		4		3		2		1		
3													
4	7		8		9		10		11		12		
5													
6	18		17		16		15		14		13		
7													
8	19		20		21		22		23		24		
9													
10	30		29		28		27		26		25		
11													
12	31		32		33		34		35		36		
13													

A. Description of original monument and accessories and/or subsequent restoration:

Survey by John and Wm. Burt on August 10-14, 1847. Set a cedar post from which a 12" hemlock bears N32°E, 12 links and a 10" hemlock - S69°E, 25 links.

1964 plat of Lake Gogebic East Shore Subdivision No. 1 - Corner is a 4" concrete monument with a 1/2" iron rod. This corner has been used in several surveys by various surveyors.

B. Description of corner evidence found and/or method applied in restoring or reestablishing corner:

Found 4" concrete monument as noted above. Accepted corner as shown on the plt as being the meander corner due to its use, longevity and the development referenced to it.

Corner record research on file.

**ONTONAGON COUNTY
PEER APPROVED**


Earl W. Applekamp
Co Rep
11-30-94

C. Description of monument for corner and accessories established to perpetuate locating the position of the corner:

I updated the corner position to state and county specifications by placing a 3 1/4" aluminum cap atop the concrete monument and stamped the cap as follows: County Remonumentation; M.C.; S-33; S-4; T48-47N, R42W; 1994; RLS 28410. I established the following bearing trees and reference objects: 4" cedar - N50°W, 7.86 feet; 3" cedar - S27°W, 9.63 feet; 4" balsam fir - S27°E, 20.29 feet; 6 foot steel rail with sign - Due North, 1.60 feet.

Signed by John R. Garske
Surveyor's Michigan License No. 28410

Date 11/2/94

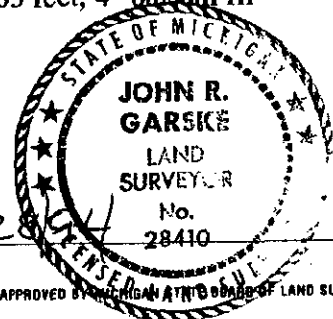

FORM APPROVED BY MICHIGAN BOARD OF LAND SURVEYORS, JAN. 28, 1971
REVISED MAY 14, 1975
REVISED JAN., 1983