

# SURVEY & REMONUMENTATION

APR 29 1996

COMMISSION

JUDITH D. ROEHM  
Ontonagon County  
LC 3/327 JEN Fee: 9.00  
Page 1 of 1

## LAND CORNER RECORDATION CERTIFICATE Filing Requirement of Act 74, Mich. P.A. 1970

For corners in

<u>Ontonagon</u> (County)	Located In:	Corner Code #
1. Public Land Survey	T <del>48N</del> R <del>42W</del>	<del>18</del> <del>17</del>
	T <del>48N</del> R <del>42W</del>	
	T <del>48N</del> R <del>42W</del>	
OTHER	T <u>48N</u> R <u>42W</u>	# 011 pm
2. Property Controlling in Section	S <del>18</del> T <del>17</del> R <del>16</del>	
	S <del>18</del> T <del>17</del> R <del>16</del>	
3. Miscellaneous Property in Sec.	S <del>18</del> T <del>17</del> R <del>16</del>	
	S <del>18</del> T <del>17</del> R <del>16</del>	

Register of Deeds Stamp & File Number

4. Lot No. \_\_\_\_\_, Recorded Plat \_\_\_\_\_  
5. Private Claims \_\_\_\_\_  
Meander corner common to Sections 17 and 18, T48N, R42W

I, John R. Garske, in a field survey on September 14, 19 95, do hereby certify that under requirements of P.A. 74, Michigan P.A. of 1970, the corner points mentioned in lines 1 and 2 above were in conformance with regulations and rules therefore as required in the current manual of survey instructions of the United States Department of the Interior, Bureau of Land Management or by a decree of a Court of Law and/or that the corner points mentioned in lines 3, 4 and 5 above were in conformance with the rules of the Michigan Board of Land Surveyors or by a Decree of a Court of Law; established, re-established, monumented, re-monumented, recovered, found as expressed below:

**NOTE: Not more than 4 corners, all in the same town and range, may be recorded on this certificate.**

	A	B	C	D	E	F	G	H	I	J	K	L	M
2	6		5		4		3		2		1		
3													
4	7		8		9		10		11		12		
5													
6	18		17		16		15		14		13		
7													
8	19		20		21		22		23		24		
9													
10	30		29		28		27		26		25		
11													
12	31		32		33		34		35		36		
13													

A. Description of original monument and accessories and/or subsequent restoration:

- On August 10, 1848, Austin Burt set a cedar post from which an 8" cedar bears N23°E, 19 links and an 8" W. birch - N19°W, 10 links.
- Corner is marked by an iron pin set by E. Applekamp - Date unknown.

B. Description of corner evidence found and/or method applied in restoring or reestablishing corner:

I found the 1/2" iron pin with a cap RLS 17610 as noted above and accepted it as being in the correct location as it lies in harmony with local residences and has been used in several surveys of record.

Record research on file with Register of Deeds.


PEER GROUP APPROVED

E. Applekamp 9-20-95  
COUNTY REPRESENTATIVE

C. Description of monument for corner and accessories established to perpetuate locating the position of the corner:

I set a 2 1/2" diameter x 30" long aluminum pipe with a 3 1/4" diameter aluminum cap stamped: County Remonumentation; T48N; R42W; M.C.; S-18; S-17; 1995; RLS 28410, from which I established the following bearing trees and/or reference objects:

- 10" cedar - N50°E - 18.39 feet
- 6" cedar - S54°E - 18.25 feet
- 10" hemlock - S19°W - 10.85 feet
- 6 foot steel rail with sign - S76°W - 1.41 feet

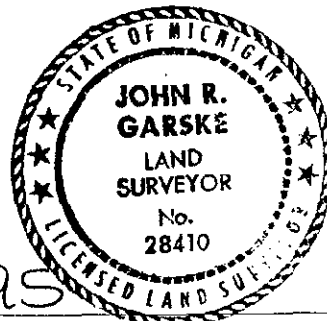

Signed by John R. Garske  
Surveyor's Michigan License No. 28410

Date 9-19-95