

LAND CORNER RECORDATION CERTIFICATE
Filing Requirement of Act 74, Mich. P.A. 1970

For corners in

Gogebic & Ontonagon
(County)

Located In:

Corner Code #

1. Public Land Survey

T 48N R 42W BG-13

T 47N R 42W BG-1

T R

M.C. OTHER T 48N R 42W #014 pm

2. Property Controlling
in Section

S T R

3. Miscellaneous
Property in Sec.

S T R

SURVEY &
REMONUMENTATION

MAY 22 1997

COMMISSION

Register of Deeds Stamp & File Number

4. Lot No. , Recorded Plat

5. Private Claims

M.C. Cor. Comm to Sec. 6, T.47 N., R.42 W.,
and Sec. 31, T.48 N., R.42 W.

I, John P. Goss, in a field survey on April 3, 19 95,
do hereby certify that under requirements of P.A. 74, Michigan P.A. of 1970, the corner points mentioned
in lines 1 and 2 above were in conformance with regulations and rules therefore as required in the
current manual of survey instructions of the United States Department of the Interior, Bureau of Land
Management or by a decree of a Court of Law and/or that the corner points mentioned in lines 3, 4 and 5
above were in conformance with the rules of the Michigan Board of Land Surveyors or by a Decree of a
Court of Law; established, re-established, monumented, re-monumented, recovered, found as
expressed below:

NOTE: Not more than 4 corners, all in the same town and range, may be recorded
on this certificate.

A. Description of original monument and accessories and/or subsequent restoration:

Original Survey by Wm. A. Burt on August 10, 1848. Set a Cedar Post.
Original Bearing Trees: Cedar 9"- S 42° W- 13 links; Y. Birch 10"-
N 72° W- 17 links.

John P. Goss in 1983 using MDOT witnesses found a 1 inch iron pin and
recorded this corner in Liber 2 pages 308 and 309 of Gogebic County
Land Corners: 6" Cedar- S 45° W- 8.78'; 8" Cedar- S 40° W- 16.87';
6" Cedar- N 65° W- 11.20'.

B. Description of corner evidence found and/or method applied in restoring or reestablishing corner:

I found the 1 inch iron pin marking the corner position and it was bent
but closes to the witnesses in John P. Goss Certificate. I updated the
corner monument and accessories as noted below to state and county
specification.

Act 74 research on file with the County Register of Deeds Office.


PEER GROUP APPROVED

PEER GROUP APPROVED
Carl W. Applekamp 4-06-95
CNT. COUNTY REPRESENTATIVE

C. Description of monument for corner and accessories established to perpetuate locating the position of the corner:

Set a 3/4" iron Pin Next to the bent 1" iron pin with a 3 1/4" Aluminum
cap on the 3/4" iron pin stamed: County Remonumentation; M.C.; S-6; S-31;
T.48 N.; T.47 N.; R.42 W.; 1995; P.S. 23509. I established the following
bearing trees and reference objects.

8" Cedar S 45° W 8.78'
9" Cedar N 65° W 16.20'
14" Cedar S 15° E 15.01'
Steel Sign Post Due West 4.51'

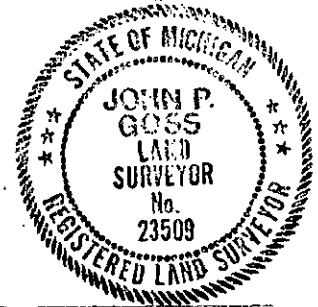

Signed by John P. Goss

Date April 3, 1995

Surveyor's Michigan License No. P.S. 23509

245