

SURVEY & REMONUMENTATION

APR 29 1996

COMMISSION

JUDITH D. ROEHM
Ontonagon County
LC 3/282 JEM Fee: 9.00
Page 1 of 1

LAND CORNER RECORDATION CERTIFICATE Filing Requirement of Act 74, Mich. P.A. 1970

For corners in

~~XXXXXX~~ Ontonagon
(County)

Located In:

Corner Code ~~##~~

1. Public Land Survey T 49 N 42 W G-5
T R
T R
T R
2. Property Controlling S T R
in Section S T R
3. Miscellaneous S T R
Property in Sec. S T R
4. Lot No. , Recorded Plat
5. Private Claims

Register of Deeds Stamp & File Number

Section Corner 9, 10, 15 & 16 T.49 N., R.42 W.

I, Richard L. Drahn, in a field survey on June 8, 19 95, do hereby certify that under requirements of P.A. 74, Michigan P.A. of 1970, the corner points mentioned in lines 1 and 2 above were in conformance with regulations and rules therefore as required in the current manual of survey instructions of the United States Department of the Interior, Bureau of Land Management or by a decree of a Court of Law and/or that the corner points mentioned in lines 3, 4 and 5 above were in conformance with the rules of the Michigan Board of Land Surveyors or by a Decree of a Court of Law; established, re-established, monumented, re-monumented, recovered, found as expressed below:

NOTE: Not more than 4 corners, all in the same town and range, may be recorded on this certificate.

A. Description of original monument and accessories and/or subsequent restoration:

Corner established by William Burt on June 10, 1848. Original BTs --- 8" Ironwood N42½W, 43 links, (28.38'); --- 18" Sugar S 35 E, 55 links (36.30')

Corner restored by Richard L. Drahn, RLS 21564 on 8/25/77 from the remains of the Sugar BT and from line trees north east and west. He set a 2" X 4' iron pipe with a 3" brass cap stamped to identify the corner. He blazed and scribed the following: --- 5" Sugar Maple N.31 W., 27.0 ft. --- 7" Sugar Maple N. 55 E., 34.3 ft. --- 5" Sugar Maple S.11 E., 52.4 Ft. --- 7' Steel Sign Rail N.04 W., 2.2 ft.

Corner recorded in Liber 1, Page 163, on 4/25/79 of Ontonagon County Records.

B. Description of corner evidence found and/or method applied in restoring or reestablishing corner:

Corner monument recovered as described in good condition. Recovered the 1977 bearing tree in good condition, (distances are to an 8 p nail placed in tree).


7"	Sugar Maple	N.32 W.	26.98 ft.
8"	Sugar Maple	N.60 E.	34.23 ft.
6"	Sugar Maple	S.11 E.	52.40 ft.
7'	Steel sign rail	N.03 W.	2.13 Ft.

PEER GROUP APPROVED
Paul W. Goldkamp
COUNTY REPRESENTATIVE
7-18-95

C. Description of monument for corner and accessories established to perpetuate locating the position of the corner:

From the above described monument I blazed and scribed the following:

8"	Sugar Maple	S.87 W.	10.62 feet
----	-------------	---------	------------

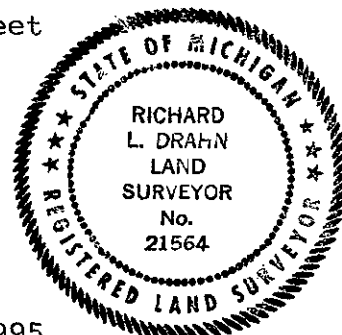

Signed by Richard L. Drahn

Date June 9, 1995

Surveyor's Michigan License No. 21564