

LAND CORNER RECORDATION CERTIFICATE

Ontonagon County

Filing Requirement of Act 74, Mich. P.A. 1970

Page 1 of 1
JEM Date 11/23/1999 Time 18:39:00
RECORDING FEE: 9.00

For corners in

Ontonagon County Located in: Corner Code #

1. Public Land Survey T51N. R40W M - 5/6
T51N. R39W A - 5/6 (002)
T R
T R
2. Property Controlling S T R
in Section S T R
3. Miscellaneous S T R
Property in Sec. S T R
4. Lot No. , Recorded Plat
5. Private Claims

SURVEY &
REMONUMENTATION

MAR 23 2000

SECTION

Register of Deeds Stamp & File Number

I, Joseph C. Domitrovich, in a field survey on November 1, 1999, do hereby state that under requirements of P.A. 74, Michigan P.A. of 1970, the corner points mentioned in lines 1 and 2 above were in conformance with regulations and rules therefore as required in the current manual of survey instructions of the United States Department of the Interior, Bureau of Land Management or by a decree of a Court of Law and /or that the corner points mentioned in lines 3, 4 and 5 above were in conformance with the rules of the Michigan Board of Land Surveyors or by a Decree of a Court of Law; established, re-established, monumented, recovered, found as expressed below:

NOTE: Not more than 2 corners, all in the same town and range, may be recorded on this certificate.

A. Description of original monument and accessories and/or subsequent restoration:

(M - 5/6 - A - 5/6) Meander Corner on Right Bank of Ontonagon River, between Section 13, T51N, R40W and 18, T51N, R39W.

1845 Austin Burt intersected the right bank of the Ontonagon River at 74.00 chains (4884.0') North of the Section Corner and set a post with ties:

14" Sugar S 28°E 8 links

No Record of Subsequent Restoration

B. Description of corner evidence found and/or method applied in restoring or reestablishing corner:

I found no remains of the original corner or accessories. The course of the river has changed dramatically since 1845 and the area of the Meander Corner is now subject to seasonal flooding. I re-established a position for the Meander Corner by single proportionate measurement. The corner now falls 110' South of the present right bank of the Ontonagon River.

Research on file with County Remonumentation Representative.


DEER GROUP APPROVED

Paul W. Applekamp
COUNTY REMONUMENTATION

C. Description of monument for corner and accessories established to perpetuate locating the position of the corner: 11-09-99

Corner is a 3/4" x 6' long aluminum rod with a 3" diameter aluminum cap stamped to read: County Remonumentation; T51N, R40W, R39W; S. 13, S. 18; M.C.; 1999; P.S. 37273. Ties:

11" Soft Maple	S 61°E	30.63'
6" Box Elder	S 08°E	17.19'
6" Soft Maple	S 25°W	30.78'
6" Elm	S 81°W	22.68'
NE Corner Section 13	N 00°33'27"W	399.16'
SE Corner Section 13	S 00°33'27"E	4923.17'

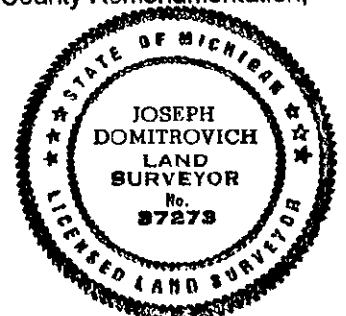

NOTE: Bearings to witness objects are magnetic. Distances are to a nail in side of the witness object unless noted.

Signed by

J. C. Domitrovich

Date

11/09/99

Surveyor's Michigan License No. 37273