

LAND CORNER RECORDATION CERTIFICATE Filing Requirement of Act 74, Mich. P.A. 1970

JUDITH D. ROEHM

1P

Ontonagon County

Page 1 of 1

LC 5/255

JEN Date 11/23/1999

Time 18:39:44

RECORDING FEE:

9.00

For corners in

Ontonagon County

Located in:

Corner Code #

1. Public Land Survey

T51N R40W M-6/7

T51N R39W A-6/7

003

2. Property Controlling
in Section

S

T R

T R

3. Miscellaneous
Property in Sec.

S

T R

T R

4. Lot No.

, Recorded Plat

5. Private Claims

SURVEY &
REMONUMENTATION

MAR 23 2000

SECTION

Register of Deeds Stamp & File Number

	A	B	C	D	E	F	G	H	I	J	K	L	M
1													
2	6		5		4		3		2		1		
3													
4	7		8		9		10		11		12		
5													
6	18		17		16		15		14		13		
7													
8	19		20		21		22		23		24		
9													
10	30		29		28		27		26		25		
11													
12	31		32		33		34		35		36		
13													

I, Joseph C. Domitrovich, in a field survey on November 5, 1999, do hereby state that under requirements of P.A. 74, Michigan P.A. of 1970, the corner points mentioned in lines 1 and 2 above were in conformance with regulations and rules therefore as required in the current manual of survey instructions of the United States Department of the Interior, Bureau of Land Management or by a decree of a Court of Law and/or that the corner points mentioned in lines 3, 4 and 5 above were in conformance with the rules of the Michigan Board of Land Surveyors or by a Decree of a Court of Law; established, re-established, monumented, recovered, found as expressed below:

NOTE: Not more than 2 corners, all in the same town and range, may be recorded on this certificate.

A. Description of original monument and accessories and/or subsequent restoration:

(M-6/7 & A-6/7) Meander Corner on the right bank of the Ontonagon River between Sections 13, T51N, R40W and 18, T51N, R39W.

1845 Austin Burt intersected the right bank of the Ontonagon River 20.60 chains (1359.60') North of the section corner and set a post with ties:

7" Elm	N 69°E	24 links
14" Elm	N 10°W	37 links

No Record of Subsequent Restoration.

B. Description of corner evidence found and/or method applied in restoring or reestablishing corner:

I found no remains of the original Meander Corner or accessories. I found no evidence of any kind of the corner position. I therefore treated the corner as lost and re-established it by single proportionate measurement.

Research on file with County Remonumentation Representative.

DEER GROUP APPROVED


Earl W. Applekamp
COUNTY REMONUMENTATION

11-09-99

C. Description of monument for corner and accessories established to perpetuate locating the position of the corner:

Corner is a 2 1/2" x 30" aluminum pipe with a 3" diameter aluminum cap stamped to read: County Remonumentation; T51N, R40W, R39W; M.C.; S. 13, S. 18; 1999; P.S. 37273. Corner falls 55' +/- North of present Right Bank of the Ontonagon River. Ties:

13" Basswood	S 80°E	7.20'
13" Cedar (w/ Rock Hanging from it)	S 65°E	24.93'
4" Basswood	S 50°W	27.05'
8" Hard Maple	N 08°W	18.67'
Steel Sign Rail	North	0.90' (to face)
SE Corner Section 13	S 00°33'27"E	1370.50'
E 1/4 Corner Section	N 00°33'27"W	1290.67'
W.C.M.C. on Left Bank	S 00°33'27"E	426.88'

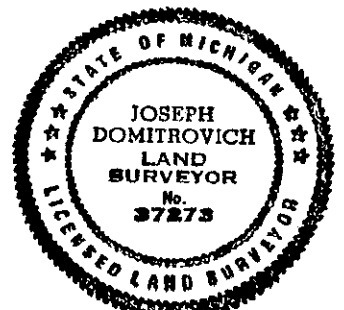

NOTE: Bearings to witness objects are magnetic. Distances are to a nail in side of the witness object unless noted.

Signed by

J. C. Domitrovich

Date

11/09/99

Surveyor's Michigan License No. 37273

FORM APPROVED BY MICHIGAN STATE BOARD OF PROFESSIONAL SURVEYORS, JAN. 28, 1971
REVISED MAY 14, 1975
REVISED JAN., 1983
REVISED OCT., 1995