

LAND CORNER RECORDATION CERTIFICATE Filing Requirement of Act 74, Mich. P.A. 1970

For corners in

ONTONAGON

(County)

Located In:

Corner Code #

1. Public Land Survey

T51N R41W

A-8

T51N R42W

M-8

T R

T R

2. Property Controlling
in Section

S

T R

S

T R

3. Miscellaneous
Property in Sec.

S

T R

S

T R

SURVEY &
REMONUMENTATION

JAN 11 1999

SECTION

Register of Deeds Stamp & File Number

4. Lot No. _____, Recorded Plat _____

5. Private Claims _____

 $\frac{1}{4}$ Corner common to Sections 19 & 24, T51N R41W & T51N R42W.

I, Earl W. Applekamp, in a field survey on March 26, 1998 do hereby state that under requirements of P.A. 74, Michigan P.A. of 1970, the corner points mentioned in lines 1 and 2 above were in conformance with regulations and rules therefore as required in the current manual of survey instructions of the United States Department of the Interior, Bureau of Land Management or by a decree of a Court of Law and /or that the corner points mentioned in lines 3, 4 and 5 above were in conformance with the rules of the Michigan Board of Land Surveyors or by a Decree of a Court of Law; established, re-established, monumented, recovered, found as expressed below:

NOTE: Not more than 2 corners, all in the same town and range, may be recorded on this certificate.

	A	B	C	D	E	F	G	H	I	J	K	L	M
1													
2	6			5			4		3		2		1
3													
4	7			8			9		10		11		12
5													
6	18			17			16		15		14		13
7													
8	19			20			21		22		23		24
9													
10	30			29			28		27		26		25
11													
12	31			32			33		34		35		36
13													

A. Description of original monument and accessories and/or subsequent restoration:

Original corner established by Austin Burt, U.S. Deputy Surveyor, August 1845. Set Wood Post.

ORIGINAL BEARING TREES:

14" Maple S26°E 13.20 feet
7" Maple N14°W 21.12 feet

B. Description of corner evidence found and/or method applied in restoring or reestablishing corner:

No original evidence was found. Area has been cleared for highway and power line construction. Corner was re-established by single proportionate measure and on line between opposite section corners North & South.

Research on file with the Ontonagon County remonumentation Representative.

PEER GROUP APPROVED

Earl W. Applekamp


COUNTY REPRESENTATIVE

5-13-98

C. Description of monument for corner and accessories established to perpetuate locating the position of the corner:

At the corner position I set a 2½"X30" split base aluminum pipe with a 3" cap stamped to read: County Remonumentation, $\frac{1}{4}$, T51N, R41W, R42W, S24, S19, 1998, P.S. 17610. I established the following five reference objects.

Nail in 6" Ash S80°W 120.18' - 6' Steel Sign Post, Due East 0.95'
Nail in 6" Maple N83°E 79.89' - Nail in P. Pole S14°E 93.75'
Center-line, Hwy. M-64 Due West 65.60'

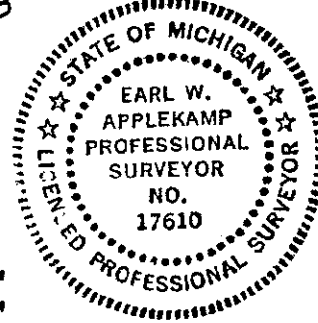

Signed by Earl W. Applekamp
Surveyor's Michigan License No. 17610

Date March 26, 1998