

APR 29 1996

COMMISSION

JUDITH D. ROEHM 11/07/95
 Ontonagon County 10:21
 LC 3/403 JEN Fee: 9.00
 Page 1 of 1

LAND CORNER RECORDATION CERTIFICATE
Filing Requirement of Act 74, Mich. P.A. 1970

For corners in
Ontonagon
 (County)

Located In:

Corner Code #

1. Public Land Survey	T	52N	R	39W	D-13
	T		R		
	T		R		
	T		R		
2. Property Controlling in Section	S		T		
	S		T		
3. Miscellaneous	S		T		
Property in Section	S		T		

Register of Deeds Stamp & File Number

4. Lot No. _____, Recorded Plat _____
 5. Private Claims _____

I, Joseph C. Domitrovich, in a field survey on October 16, 19 95, do hereby certify that under requirements of P.A. 74, Michigan P.A. of 1970, the corner points mentioned in lines 1 and 2 above were in conformance with regulations and rules therefore as required in the current manual of survey instructions of the United States Department of the Interior, Bureau of Land Management or by a decree of a Court of Law and/or that the corner points mentioned in lines 3, 4 and 5 above were in conformance with the rules of the Michigan Board of Professional Surveyors or by a Decree of a Court of Law; established, re-established, monumented, re-monumented, recovered, found as expressed below:

NOTE: Not more than 4 corners, all in the same town and range, may be recorded on this certificate.

A. Description of original monument and accessories and/or subsequent restoration:

South 1/4 Corner, Section 32, T52N, R39W

1845 -William A. Burt set Fir 1/4 post

24" Hemlock N 74° E 29 links
 14" Hemlock N 27° W 33 links

1983 -Robert Mick P.S. 16936, recorded survey in Liber 1, p. 59 of Surveys shows corner and distance to section corners east and west. Also in Liber 2, p. 112 of Corner Records he states that he established corner position by projecting an old fenceline from north and intersecting it with a line between standard corners. He states that this position agreed very closely with original stream ties to east and west. He set a 1/2" capped iron at this location and established 3 new bearing trees.

B. Description of corner evidence found and/or method applied in restoring or reestablishing corner:

Entire area around corner has been cleared and no evidence remains of the original corner. Found the corner as set by Mick and his 3 new bearing trees. The corner however does not fall on line between section corners and his distances east and west to standard corners vary considerably, but corner does work well with fences and natural features and has been relied on as the 1/4 corner position for a number of years. Accepted corner as the South 1/4 Corner of Section 32, T52N, R39W and replaced.

Research on file with County Remonumentation Representative.

PEER GROUP APPROVED

Paul Applekamp
 COUNTY REPRESENTATIVE


11-06-95

C. Description of monument for corner and accessories established to perpetuate locating the position of the corner:

Corner is an aluminum pipe with a 3" diameter stamped aluminum cap and falls in a partial clearing of Poplar and White Birch growth.

Witnesses:

3" White Birch	S 58° E	8.80'	
4" Poplar	S 40° W	47.82'	(Added blaze & nail to found N.B.T.)
7" Poplar	N 85° W	53.72'	(Added blaze & nail to found N.B.T.)
5" Poplar	N 24° W	11.37'	(Added blaze & nail to found N.B.T.)
Steel Sign Post	North	1.07'	

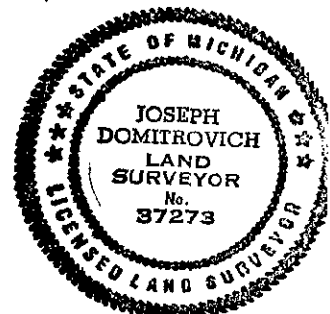

NOTE: Bearings are magnetic. Distances are to nail in side of witness objects unless noted.

Signed by J. C. Domitrovich

Date 11/5/95

Surveyor's Michigan License No. 37273