

SURVEY &
REMONUMENTATION

APR 29 1996

JUDITH D. ROEHM
Ontonagon County
LC 3/340 JEM Fee: 9.00
Page 1 of 1

COMMISSION

LAND CORNER RECORDATION CERTIFICATE
Filing Requirement of Act 74, Mich. P.A. 1970

For corners in
Ontonagon
(County)

Located In:

Corner Code #

1. Public Land Survey

T ~~52N~~ R ~~39W~~

~~002~~

T R

OTHER T 52N R 39W

002

T R

2. Property Controlling
in Section

S T R

S T R

3. Miscellaneous

S T R

Property in Section

S T R

Register of Deeds Stamp & File Number

4. Lot No. , Recorded Plat

5. Private Claims

I, Joseph C. Domitrovich, in a field survey on October 11, 1995,
do hereby certify that under requirements of P.A. 74, Michigan P.A. of 1970, the corner points mentioned
in lines 1 and 2 above were in conformance with regulations and rules therefore as required in the current
manual of survey instructions of the United States Department of the Interior, Bureau of Land
Management or by a decree of a Court of Law and/or that the corner points mentioned in lines 3, 4 and
5 above were in conformance with the rules of the Michigan Board of Professional Surveyors or by a
Decree of a Court of Law; established, re-established, monumented, re-monumented, recovered, found
as expressed below:

**NOTE: Not more than 4 corners, all in the same town and range, may be recorded
on this certificate.**

A. Description of original monument and accessories and/or subsequent restoration:

(C-7/8) Meander Corner, Sections 19 & 20 T52N, R39W

1845 - William A. Burt set post at shore of Lake Superior 6.64 chains (438.2') North of the 1/4 corner sections 19/20.

8" White Birch S 85° E 10 links.

A	B	C	D	E	F	G	H	I	J	K	L	M
2	6	5	4	3	2							
3												
4	7	8	9	10	11	12						
5												
6	18	17	16	15	14	13						
7												
8	19	20	21	22	23	24						
9												
10	30	29	28	27	26	25						
11												
12	31	32	33	34	35	36						
13												

B. Description of corner evidence found and/or method applied in restoring or reestablishing corner:

All evidence of the original Corner and has been lost due to shoreline erosion and no evidence of subsequent perpetuation is
evident.

A Witness Corner to the original Meander Corner was established on line with the section corner and 1/4 corner to the south,
318.64' feet North of the 1/4 corner.

(Research on file with County Remonumentation Representative.)

C. Description of monument for corner and accessories established to perpetuate locating the position of the corner:


Corner is a 3/4" x 36" aluminum rod with 3" diameter stamped aluminum cap, and it falls approximately 10' south of the top of
bank.

Witnesses:

12" Soft Maple	N 76° E	11.80'
40" Hemlock	S 30° E	17.58'
8" White Birch	S 12° W	22.80'
Sign Post	North	0.71'

PEER GROUP APPROVED

COUNTY REPRESENTATIVE

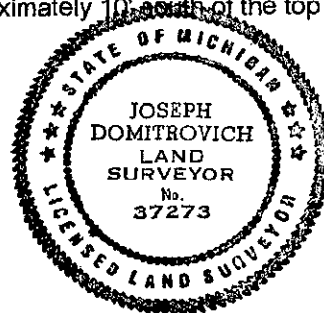

NOTE: Bearings are magnetic. Distances are to nail in side of witness objects unless noted.

Signed by Joseph C. Domitrovich

Date 10/10/95

Surveyor's Michigan License No. 37273

FORM APPROVED BY MICHIGAN STATE BOARD OF PROFESSIONAL SURVEYORS, JAN. 28, 1971
REVISED MAY 14, 1975
REVISED JAN., 1983