

SURVEY &  
REMONUMENTATION

APR 29 1996

COMMISSION

LAND CORNER RECORDATION CERTIFICATE

Filing Requirement of Act 74, Mich. P.A. 1970

JUDITH D. ROEHM  
Ontonagon County  
LC 3/351 JEM Fee: 9.00  
Page 1 of 1

For corners in  
Ontonagon  
(County)

Located In:

Corner Code #

1. Public Land Survey

T ~~52N~~ R ~~39W~~

~~52N~~ ~~39W~~

T ~~52N~~ R ~~39W~~

~~52N~~ ~~39W~~

T ~~52N~~ R ~~39W~~

~~52N~~ ~~39W~~

OTHER T 52N R 39W

005

2. Property Controlling  
in Section

S ~~52N~~ T ~~39W~~

~~52N~~ ~~39W~~

3. Miscellaneous

S ~~52N~~ T ~~39W~~

~~52N~~ ~~39W~~

Property in Section

S ~~52N~~ T ~~39W~~

~~52N~~ ~~39W~~

Register of Deeds Stamp & File Number

4. Lot No. \_\_\_\_\_, Recorded Plat \_\_\_\_\_

5. Private Claims \_\_\_\_\_

I, Joseph C. Domitrovich, in a field survey on October 11, 1995, do hereby certify that under requirements of P.A. 74, Michigan P.A. of 1970, the corner points mentioned in lines 1 and 2 above were in conformance with regulations and rules therefore as required in the current manual of survey instructions of the United States Department of the Interior, Bureau of Land Management or by a decree of a Court of Law and/or that the corner points mentioned in lines 3, 4 and 5 above were in conformance with the rules of the Michigan Board of Professional Surveyors or by a Decree of a Court of Law; established, re-established, monumented, re-monumented, recovered, found as expressed below:

**NOTE: Not more than 4 corners, all in the same town and range, may be recorded on this certificate.**

A. Description of original monument and accessories and/or subsequent restoration:

Meander Corner Sections 16 and 15, T52N, R39W

1845 - William A. Burt intersected Lake Superior 5.26 chains (347.16') north of 1/4 corner and set post.

12" Yellow Birch S 77° E 22 links

1922 - E. J. Donnelly, C. E. noted in original notes (p.45) on file at Ontonagon County Register of Deeds, that he set a stake by bank of Lake at an angle of 0° 22' 28.7" west of a right angle to the Main Road (south line of section) and 267.4' north of "2640 stake".

Undated - A map of a proposed subdivision on file at Ontonagon County Equalization office shows Meander Corner at 2841.60' north of Section Corner.

B. Description of corner evidence found and/or method applied in restoring or reestablishing corner:

Found no remaining evidence of original corner position due to severe shoreline erosion and the construction of 4 Mile Rock road.

Established a Witness Corner to the Meander Corner on line with the 1/4 corner and section corner to the south at a distance of 162.61' north of the 1/4 corner.

Corner works well with position of 4 Mile Rock road.

(Research on file with County Remonumentation Representative.)

C. Description of monument for corner and accessories established to perpetuate locating the position of the corner:

Corner is a 5/8" x 24" rerod with 3" diameter stamped aluminum cap and falls 1' east of centerline 4 Mile Rock road and 95' south of the shore of Lake Superior.

Witnesses:

Reference Monument with Stamped Aluminum Cap

Sign Post

18" Soft Maple

7" Ash

1/4 Corner Sections 16 & 15 (5/8" rerod w/stamped cap)

14" White Birch

East 20.87'

East 21.67'

S 84° E 42.66'


S 57° E 29.03'

South 162.61'

S 88° W 41.92'

PEER GROUP APPROVED

Paul W. Applekamp 10-18-95  
COUNTY REPRESENTATIVE

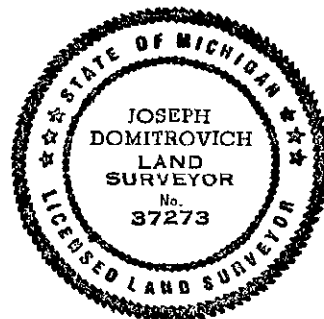

**NOTE:** Bearings are magnetic. Distances are to nail in side of witness objects unless noted.

Signed by J. C. Domitrovich

Date 10/18/95

Surveyor's Michigan License No. 37273

FORM APPROVED BY MICHIGAN STATE BOARD OF PROFESSIONAL SURVEYORS, JAN. 28, 1971  
REVISED MAY 14, 1975  
REVISED JAN., 1983