

LAND CORNER RECORDATION CERTIFICATE  
Filing Requirement of Act 74, Mich. P.A. 1970 as Amended

For corners in

Ontonagon (County)	Located In:	Corner Code #
1. Public Land Survey	T 53N R 37W	A7
	T R	
	T R	
2. Property Controlling in Section	S T R	
	S T R	
	S T R	
3. Miscellaneous Property in Sec.	S T R	
	S T R	
4. Lot No. , Recorded Plat		
5. Private Claims		

Register of Deeds Stamp & File Number

	A	B	C	D	E	F	G	H	I	J	K	L	M
1													
2	6		5		4		3		2		1		
3													
4	7		8		9		10		11		12		
5													
6	18		17		16		15		14		13		
7													
8	19		20		21		22		23		24		
9													
10	30		29		28		27		26		25		
11													
12	31		32		33		34		35		36		
13													

I, Stephan J. Szyszkoski, in a field survey on 08/30/2012 do hereby state that under requirements of P.A. 74, Michigan P.A. of 1970, the corner points mentioned in lines 1 and 2 above were in conformance with regulations and rules therefore as required in the current manual of survey instructions of the United States Department of the Interior, Bureau of Land Management or by a decree of a Court of Law and /or that the corner points mentioned in lines 3, 4 and 5 above were in conformance with the rules of the Michigan Board of Land Surveyors or by a Decree of a Court of Law; established, re-established, monumented, recovered, found as expressed below:

NOTE: Not more than 2 corners, all in the same town and range, may be recorded on this certificate.

A. Description of original monument and accessories and/or subsequent restoration:


(A7) Section corner on the Range line common to Sections 18-19 T53N-R37W and Sections 13-24 T53N-R38W. 1845 - Established by Wm.A.Burt Deputy Surveyor. Set post. Hemlock 16" S32W 7 links, Hemlock 16" N63W 43 links. 1846 - Deputy Surveyors Higgins and Hubbard added the following witnesses: Hemlock 24" N41E 31 links, Hemlock 24" S52E 10 links. 1965 - Billy D. Buckler RLS found the corner marked with a wooden post on a cutting edge. 1980 - K.L.Sackett RLS found the corner marked with two old pipes and scribed post. He used this position to establish corners on the south and west lines of Section 18 in 1981. The field notes of Mr. Sackett's survey show that he also found a second pipe N52E 20.35' distant which he did not accept. His witnesses to the corner: 12" Cedar N25E 32.6', 4" Cedar S89E 28.7', 14" Hemlock N26W 45.2'.

B. Description of corner evidence found and/or method applied in restoring or reestablishing corner:

(A7) The original post and accessories were not recovered. Found the corner marked with a 1/2" ID iron pipe projecting 1.9' a.g. with old rotten post laying on ground, adjacent. Found an aluminum pipe adjacent. Also found the pipe noted by Mr. Sackett N52E 20.35' distant. Two remaining 1980 NBTs were found at record bearing and distance (described below). The corners along the west and south lines of Sec. 18 established in 1981 were recovered and conform to this position. Accepted the 1/2" ID pipe as the best available evidence of the position of the original corner and replaced it with a new monument. All pipes noted above were removed.

C. Description of monument for corner and accessories established to perpetuate locating the position of the corner:

(A7) Set 1"IDx32" I.pipe with 4" alum. MDNR cap. Set measuring nail with MDNR tag in the side of: 17" Hemlock N22W 45.5' old blazes 1980 NBT 12" Cedar N29E 33.35' scribing plain do 4" Maple S38E 26.05' mrkd "S19 NBT" 9" Y.Birch S43W 9.6' "S24 NBT" Set sq'd cedar post adjacent. Bearings are magnetic.

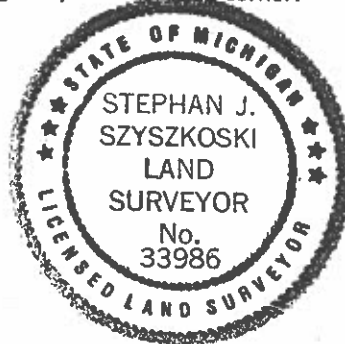

Signed by Stephan J. Szyszkoski  
Surveyor's Michigan License No. 33986

Date 11/29/2012

For the Michigan Department of Natural Resources, Forest Resources Division