

LAND CORNER RECORDATION CERTIFICATE
Filing Requirement of Act 74, Mich. P.A. 1970

corners in

<u>Presque Isle</u> (County)	Located In:	Corner Code #
Public Land Survey	T 34N R 4E	G-2
	T R	
	T R	
	T R	
Property Controlling Section	S T R	
	S T R	
miscellaneous	S T R	
Property in Sec.	S T R	

PRESQUE ISLE COUNTY
RECORDED

98 DEC 17 PM 4:25

Janet M. Lamb
REGISTER OF DEEDS

Register of Deeds Stamp & File Number

No. _____, Recorded Plat _____
Private Claims _____

A	B	C	D	E	F	G	H	I	J	K	L	M
1												
2	6		5		4	●	3		2		1	
3												
4	7		8		9		10		11		12	
5												
6	18		17		16		15		14		13	
7												
8	19		20		21		22		23		24	
9												
10	30		29		28		27		26		25	
11												
12	31		32		33		34		35		36	
13												

Delmer E. Porter in a field survey on July 2, 1998 do hereby state that under provisions of P.A. 74, Michigan P.A. of 1970, the corner points mentioned in lines 1 and 2 above were in accordance with regulations and rules therefore as required in the current manual of survey instructions of the States Department of the Interior, Bureau of Land Management or by a decree of a Court of Law and for the corner points mentioned in lines 3, 4 and 5 above were in conformance with the rules of the Michigan of Land Surveyors or by a Decree of a Court of Law; established, re-established, monumented, re-established, found as expressed below:

Not more than 2 corners, all in the same town and range, may be recorded on this certificate.

Description of original monument and accessories and/or subsequent restoration:

GLO NOTES
June 26, 1856
W Pine 10 N20W 134 Links
W Pine 10 S68E 103 Links
Old Quarter Corner
East Effaced
Birch 12 N45E 13
Hem 8 S58W 3

SURVEY &
REMONUMENTATION

JAN 14 1999


SECTION

Description of corner evidence found and/or method applied in restoring or reestablishing corner:

Found 1"X5' Pipe
S86°W 296.00' 18" W. Pine
N83°W 180.08' 14" W. Pine
N17°W 87.94' 6" Cedar

Description of monument for corner and accessories established to perpetuate locating the position of the corner:

1" Pipe in 3' Water - Beaver Pond
S86°W 296.00' 18" W. Pine
N83°W 180.08' 15" W. Pine
N17°W 87.94' 6" Cedar
S86°W 66' 10" Cedar Post

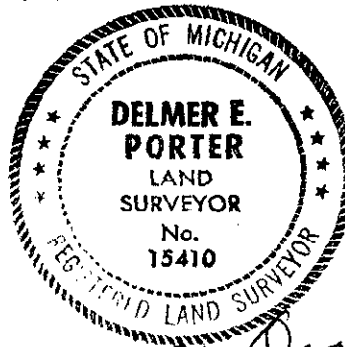

Ratified by Peer Group
in accordance with P.A. 345
Chairman *Norman J. Quinn*
Date 12/17/98

by *Delmer E. Porter*
Michigan License No. #15410

Date Dec 9, 1998