

1999 PRESQUE ISLE COUNTY, STATE OF MICHIGAN,

LAND CORNER REMONUMENTATION

LIBER 335 PAGE 221

DEC 29 1999

SECTION

LAND CORNER RECORDATION CERTIFICATE
Filing Requirement of Act 74, Mich. P.A. 1970

For corners in
PRESQUE ISLE

Located in:

Corner Code #

BISMARCK TWP.

MPOST

1. Public Land Survey

T 34 N R 4 E

11

2. Property Controlling
in Section

S T R

3. Miscellaneous
Property in Sec.

S T R

Recorded Dec. 20, 1999
At 10:30 o'clock A M
Janet M. Lamb
Reg. of Deeds, Presque Isle Co. MI

Register of Deeds Stamp & File Number

4. Lot No. _____, Recorded Plat _____
5. Private Claims _____

James A. Beck in a field survey on Nov 30, 1999 do hereby state that under requirements of P.A. 74, Michigan P.A. of 1970, the corner points mentioned in lines 1 and 2 above were in conformance with regulations and rules therefore as required in the current manual of survey instructions of the United States Department of the Interior, Bureau of Land Management or by a decree of a Court of Law and for that the corner points mentioned in lines 3, 4 and 5 above were in conformance with the rules of the Michigan Board of Land Surveyors or by a Decree of a Court of Law; established, re-established, monumented, recovered, found as expressed below:

NOTE: Not more than 2 corners, all in the same town and range, may be recorded on this certificate.

	A	B	C	D	E	F	G	H	I	J	K	L	M
1													
2	6		5		4		3		2		1		
3													
4	7		8		9		10		11		12		
5													
6	18		17		16		15		14		13		
7													
8	19		20		21		22		23		24		
9													
10	30		29		28		27		26		25		
11													
12	31		32		33		34		35		36		
13													

A. Description of original monument and accessories and/or subsequent restoration:

Meander point between Secs 31 and 32 on N. side
of spit of land in Lake Nettle
1856 G.L.O. by Alfred Miller
"Intersect Lake & Set Meander Post"
Y. Pine 11 S25E 16
Y. Pine 10 N23W 17

Oct 4, 1973 P.A. 132 Survey by Delmer E. Porter RLS 15410
"North Meander Post"; 1/2" pipe 1' from water
10" Norway S35°W 16.20'
6" Cedar S15°E 13.64'
6" Cedar S85°W 12.82'


By Footenbury
in accordance with P.A. 345
Chairman James A. Beck
Date 12/14/99

B. Description of corner evidence found and/or method applied in restoring or reestablishing corner:

Meander point between Secs 31 and 32 on N. side of spit of land in Lake Nettle
November 30, 1999 Remonumentation by James A. Beck P.S. 21559
found 1/2" pipe, S35°W 15.70' " " " 14" R. Pine
S85°W 12.85' " " " 8" Cedar

C. Description of monument for corner and accessories established to perpetuate locating the position of the corner:

Meander point between Secs 31 and 32 on N. side of spit of land in Lake Nettle
November 30, 1999 Remonumentation by James A. Beck P.S. 21559
1/2" pipe & set P.S. 21559 cap in pipe
S43°E 17.79' P.S. 22428 (R. Bischer) tag in 5" Spruce
S35°W 15.70' " " " 14" R. Pine
S85°W 12.85' " " " 8" Cedar
N68°W 19.85' " " " 4" Cedar

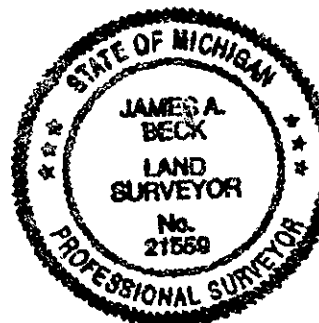

Signed by James A. Beck
Surveyor's Michigan License No. 21559

Date 12-18-1999