

1993

COMMIC

PRESQUE ISLE COUNTY  
RECORDED

93 DEC 22 AM 10:02

## LAND CORNER RECORDATION CERTIFICATE

Filing Requirement of Act 74, Mich. P.A. 1970

For corners in

PRESQUE ISLE  
(County)

Located In:

Corner Code #

*James M. Lamb*  
REGISTER OF DEEDS

1. Public Land Survey T 34N R 2E D-11  
T R  
T R  
T R
2. Property Controlling S T R  
in Section S T R
3. Miscellaneous S T R  
Property in Sec. S T R

Register of Deeds Stamp &amp; File Number

4. Lot No. \_\_\_\_\_, Recorded Plat \_\_\_\_\_
5. Private Claims \_\_\_\_\_

I, DELMER E. PORTER a field survey on DEC. 9, 19 93,  
do hereby certify that under requirements of P.A. 74, Michigan P.A. of 1970, the corner points mentioned  
in lines 1 and 2 above were in conformance with regulations and rules therefore as required in the  
current manual of survey instructions of the United States Department of the Interior, Bureau of Land  
Management or by a decree of a Court of Law and/or that the corner points mentioned in lines 3, 4 and 5  
above were in conformance with the rules of the Michigan Board of Land Surveyors or by a Decree of a  
Court of Law; established, re-established, monumented, re-monumented, recovered, found as  
expressed below:

NOTE: Not more than 4 corners, all in the same town and range, may be recorded  
on this certificate.

## A. Description of original monument and accessories and/or subsequent restoration:

D-11 GLO NOTES

JULY 18, 1855

SPRUCE 5" N 71° E 19 lks.

TAMARACK 5" S 45° E 23 lks.

REPLACED 4" SQUARE FENCE POST

MENTIONED BY MSHD WITH 4" CONCRETE  
MONUMENT AND BRASS CAP

S 69° E 12.61' 4" TAMARACK

S 35° E 12.89' 7" TAMARACK

S 25° W 25.98' 5" TAMARACK

D-11

P.A. 74 FILING BY DELMER E. PORTER

L.S. 15410 NOV. 9, 1978 PAGE 319 LAND CORNER RECORD

## B. Description of corner evidence found and/or method applied in restoring or reestablishing corner:

D-11 DEC. 9, 1993

FOUND CONCRETE MONUMENT AND BRASS CAP

S 35° E 13.95' 7" TAMARACK

S 67° E 12.75' 5" TAMARACK

Ratified by Peer Group  
in accordance with P.A. 345Chairman *Delmer E. Porter*Date *December 18, 1993*

## C. Description of monument for corner and accessories established to perpetuate locating the position of the corner:

D-11

4" CONCRETE MONUMENT WITH BRASS CAP

S 26° W 22.15' 8" TAMARACK


S 35° E 13.95' 7" TAMARACK

S 67° E 12.75' 5" TAMARACK

N 51° E 56.47' 9" TAMARACK

\* NAILS AND TAGS #15410 USED ON WITNESSES

PORTER'S SURVEY, P.C.

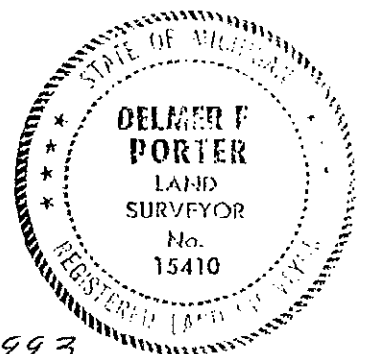

Signed by

*Delmer E. Porter*

Date

*Dec 20, 1993*

Surveyor's Michigan License No.

15410

# CORNER HISTORY RESEARCH SHEET

D-11

T34N,R2E ALLIS TOWNSHIP-NORTH PART,  
PRESQUE ISLE COUNTY, MICHIGAN.

## ACTIVITY      MONUMENT & ACCESSORIES      -      COMMENTS

GLO Survey  
July 18, 1855

Spruce 5" N71°E 19 Links  
Tamarac 5" S45°E 23 Links

Act 74 filing by  
Delmer E. Porter #15410  
Nov. 9, 1978, Page 319  
Corner Recordation

Found Square Fence Post  
M.S.D.H.  
N63°E 4.05' 10" Elm  
S35°E 12.95' 7" Tam.  
Replaced w/P.I. Co. Remon.  
Conc. Mon. & Brass Cap  
S69°E 12.61' 4" Tam.  
S35°E 12.89' 7" Tam.  
S25°W 25.98' 5" Tam.

Presque  
Isle Co.  
Remon.  
Project

Presque Isle  
Remonumentation  
Dec. 9, 1993

Fd. Conc. Mon. with Brass Cap  
and same witnesses as above  
S26°W 22.15' 8" Tamarack  
S35°E 13.95' 7" Tamarack  
S67°E 12.75' 5" Tamarack  
N51°E 56.47' 9" Tamarack

#4/