

93 DEC 20 PM 4:49

LAND CORNER RECORDATION CERTIFICATE  
Filing Requirement of Act 74, Mich. P.A. 1970

For corners in

PRESQUE ISLE  
(County)

Located In:

Corner Code F-7*Janet M. Lamb*  
REGISTER OF DEEDS

1. Public Land Survey T 34N R 2E F-7  
T \_\_\_\_\_ R \_\_\_\_\_  
T \_\_\_\_\_ R \_\_\_\_\_  
T \_\_\_\_\_ R \_\_\_\_\_  
2. Property Controlling S \_\_\_\_\_ T \_\_\_\_\_ R \_\_\_\_\_  
in Section S \_\_\_\_\_ T \_\_\_\_\_ R \_\_\_\_\_  
3. Miscellaneous S \_\_\_\_\_ T \_\_\_\_\_ R \_\_\_\_\_  
Property in Sec. S \_\_\_\_\_ T \_\_\_\_\_ R \_\_\_\_\_

LIBER **307** PAGE **920**

Register of Deeds Stamp &amp; File Number

4. Lot No. \_\_\_\_\_, Recorded Plat \_\_\_\_\_  
5. Private Claims \_\_\_\_\_

I, Ronald R. Bischer, in a field survey on September 14, 19 93, do hereby certify that under requirements of P.A. 74, Michigan P.A. of 1970, the corner points mentioned in lines 1 and 2 above were in conformance with regulations and rules theretofore as required in the current manual of survey instructions of the United States Department of the Interior, Bureau of Land Management or by a decree of a Court of Law and/or that the corner points mentioned in lines 3, 4 and 5 above were in conformance with the rules of the Michigan Board of Land Surveyors or by a Decree of a Court of Law; established, re-established, monumented, re-monumented, recovered, found as expressed below:

**NOTE: Not more than 4 corners, all in the same town and range, may be recorded on this certificate.**

A. Description of original monument and accessories and/or subsequent restoration:

F-7

1855 Resurvey - Geo H. Cannon (July) N81°E 118.56' 20" W. pine  
Set Wood Post N04°E 35.78' Fe. corner  
16" Beech N08°W 12 links Recorded on Page 164, Land  
14" Sugar S10°E 30½ links Recordation, November 24, 1976.  
1976 - Ronald R. Bischer 1" Bar was replaced by ½" Rod at an  
Found 1" Bar unknown date. ½" Rod fits witnesses.  
S50°W 64.85' 16" Hemlock

B. Description of corner evidence found and/or method applied in restoring or reestablishing corner:

F-7


Found ½" Rod in Monument Box  
S50°W 64.85' 18" Hemlock  
N77°E 118.56' 22" White pine

Set Cap #22428 on ½" Rod.

SURVEY &  
MONUMENTATION

1093

COMMISSION

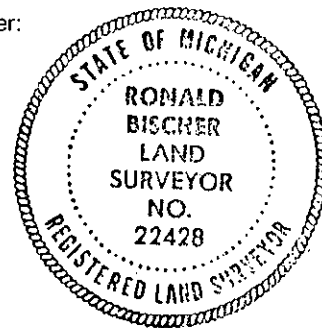

C. Description of monument for corner and accessories established to perpetuate locating the position of the corner:

F-7

½" Rod and Cap #22428 in Monument Box  
S50°W 64.85' 18" Hemlock  
N77°E 118.56' 22" White pine  
Due S 33.00' ½" Rod and Cap #22428  
S54°E 66.81' 7" Beech

\*Witness tags and nails used.

Ratified by Peer Group  
in accordance with P.A. 345  
Chairman *Delmar E. Porter*  
Date December 7, 1993

Signed by Ronald R. BischerDate 12-13-93Surveyor's Michigan License No. 22428

## CORNER HISTORY RESEARCH SHEET

LIBER 307 PAGE 921

F-7 Corner, Section 16, 21, Township 34N Range 2E

Activity	Monument & Accessories	Notes
1855 Resurvey Geo. H. Cannon	Set Wood Post 16" Beech N08°W 12 links 14" Sugar S10°E 30½ links	
1976 Ronald R. Bischer #22428	Found 1" Bar Set three witnesses. Recorded on Page 164, Land Recordation, November 24, 1976	1" Bar was replaced with ½" Rod at an unknown date. ½" rod fits witnesses.
1993 Remonumentation Ronald R. Bischer #22428	Found ½" Rod in Monument box, set cap #22428 S50°W 64.85' 18" Hemlock found nail w/tag #15410 N77°E 118.56' 22" White Pine found nail w/tag #15410 South 33.00' ½" Rod & cap #22428 S54°E 66.81' 7" Beech set nail w/tag #22428	

#3