

93 DEC 22 AM 10:02

1993

LAND CORNER RECORDATION CERTIFICATE
Filing Requirement of Act 74, Mich. P.A. 1970*Janet M. Lamb*
REGISTER OF DEEDS

For corners in

PRESQUE ISLE
(County)

Located in:

Corner Code #

- | | | |
|------------------------------------|--------------------------|------------|
| 1. Public Land Survey | T <u>34N</u> R <u>2E</u> | <u>F-9</u> |
| | T _____ R _____ | _____ |
| | T _____ R _____ | _____ |
| | T _____ R _____ | _____ |
| 2. Property Controlling in Section | S _____ T _____ R _____ | _____ |
| | S _____ T _____ R _____ | _____ |
| 3. Miscellaneous Property in Sec. | S _____ T _____ R _____ | _____ |
| | S _____ T _____ R _____ | _____ |

Register of Deeds Stamp & File Number

4. Lot No. _____, Recorded Plat _____
5. Private Claims _____

I, DELMER E. PORTER field survey on SEPT. 12, 19 93, do hereby certify that under requirements of P.A. 74, Michigan P.A. of 1970, the corner points mentioned in lines 1 and 2 above were in conformance with regulations and rules therefore as required in the current manual of survey instructions of the United States Department of the Interior, Bureau of Land Management or by a decree of a Court of Law and/or that the corner points mentioned in lines 3, 4 and 5 above were in conformance with the rules of the Michigan Board of Land Surveyors or by a Decree of a Court of Law; established, re-established, monumented, re-monumented, recovered, found as expressed below:

NOTE: Not more than 4 corners, all in the same town and range, may be recorded on this certificate.

	A	B	C	D	E	F	G	H	I	J	K	L	M
2	6		5		4		3		2		1		
3													
4	7		8		9		10		11		12		
5													
6	13		17		16		15		14		13		
7													
8	19		20		21		22		23		24		
9													
10	30		29		28		27		26		25		
11													
12	31		32		33		34		35		36		
13													

A. Description of original monument and accessories and/or subsequent restoration:

F-9 GLO NOTES

JULY 16, 1855

CEDAR 10" N 50° W 29 lks.

CEDAR 10" S 20° E 20½ lks.

WITNESSES

NORTH 41.06' FENCE CORNER

SOUTH 26.43' FENCE CORNER

S 15° E 32.72' 10" CEDAR

N 20° W 49.91' P. POLE

F-9 P.A. 74 FILING BY DELMER E. PORTER

LS. #15410 MAY 1, 1974 PG. 45

LAND CORNER RECORDS

SET ½" ROD AND CAP AT FENCE LINE

NORTH & SOUTH ON LINE BETWEEN SECTION CORNERS

B. Description of corner evidence found and/or method applied in restoring or reestablishing corner:

F-9

SEPT. 12, 1993

FOUND ½" ROD & CAP #15410

NORTH 41.06' FENCE CORNER

SOUTH 26.43' FENCE CORNER

S 15° E 32.72' 10" CEDAR

LEFT SAME

Ratified by Peer Group
in accordance with P.A. 345Chairman *Delmer E. Porter*Date December 14, 1993

C. Description of monument for corner and accessories established to perpetuate locating the position of the corner:

F-9

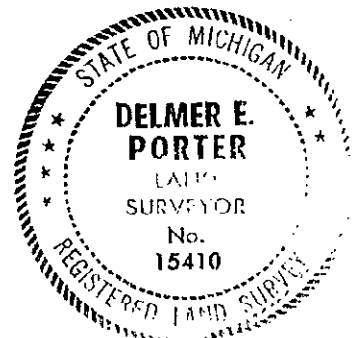
½" ROD & CAP #15410

N 24° W 55.41' 10" ELM

N 01° E 37.94' 5" ASPEN

N 41° E 49.46' 5" BALSAM

S 11° E 32.45' 10" CEDAR

* NAILS AND TAGS #15410 USED IN WITNESSES
PORTER'S SURVEY, P.C.

Signed by

Delmer E. Porter

Date

Dec 20, 1993

Surveyor's Michigan License No.

15410

CORNER HISTORY RESEARCH SHEET

F-9

T34N,R2E ALLIS TOWNSHIP-NORTH PART,
PRESQUE ISLE COUNTY, MICHIGAN.

ACTIVITY MONUMENT & ACCESSORIES - COMMENTS

GLO Survey
July 16, 1855

Cedar 10" N50°W 29 Links
Cedar 10" S20°E 20 1/2 Links

Act 74 filing by:
Delmer E. Porter,
#15410, May 1, 1974,
Page 45, Corner
Recordation

Set 1/2" Rod & Cap on Line
Between NE Cor. & NW Cor.
and in line w/fence
North 41.06' Fe. Cor.
South 26.43' Fe. Cor.
S15°E 32.72' 10" Cedar
N20°W 49.91' P. Pole

Act 132 Survey by:
Delmer E. Porter,
#15410, Apr.30, 1974,
Survey#30-74
Lib. 205, Pg. 167

1/2" Rod & Cap
N20°W 49.91' P. Pole
S15°E 32.72' 10" Cedar

Act 132 Survey by:
Delmer E. Porter,
#15410, Sept.25, 1980,
Survey#89-80
File#34R2117
Lib. Pg.

1/2" Rod & Cap
North 41.06' Fe. Cor. Post.
South 26.43' Fe. Cor. Post
S20°W 49.91' P. Pole

Act 132 Survey by:
Delmer E. Porter,
#15410, Aug.8, 1984,
Survey#73-84
File#34R2159
Lib. Pg.

1/2" Rod & Cap
Same as 1974 recording

Act 132 Survey by:
Delmer E. Porter,
#15410, May 11, 1986,
Survey#21-86
File#34R2187
Lib. 279, Pg. 710

Same as 1974 recording

Act 132 Survey by:
Delmer E. Porter,
#15410, Apr.13, 1990
Survey#168-89
File#34R2233

1/2" Rod & Cap
North 41.06' Fe. Cor.
South 26.43' Fe. Cor.
S15°E 32.72' 10" Cedar

Act 132 Survey by:
Delmer E. Porter,
#15410, Apr.23, 1992
Survey#40-92
File#34R2259
Unrecorded

Same as 1974 Recording

Remonumentation
Sept. 12, 1993

Fd. 1/2" Rod & Cap #15410
North 41.06' Fe. Cor.
South 26.43' Fe. Cor.
S15°E 32.72' 10" Cedar
Left Same
N24°W 55.41' 10" Elm
N01°E 37.94' 5" Aspen
N41°E 49.46' 5" Balsam
S11°E 32.45' 10" Cedar

JAN 22 2001

SECTION