

93 DEC 20 PM 4:50

LAND CORNER RECORDATION CERTIFICATE
Filing Requirement of Act 74, Mich. P.A. 1970

For corners in

PRESQUE ISLE Located In: Corner Code ##
(County)

1. Public Land Survey T 34N R 2E I-3
T _____ R _____
T _____ R _____
T _____ R _____

2. Property Controlling S _____ T _____ R _____
in Section S _____ T _____ R _____

3. Miscellaneous S _____ T _____ R _____
Property in Sec. S _____ T _____ R _____

John M. Lamb
REGISTER OF DEEDSLIBER **307** PAGE **948**

Register of Deeds Stamp & File Number

4. Lot No. _____, Recorded Plat _____
5. Private Claims _____

	A	B	C	D	E	F	G	H	I	J	K	L
2	6		5		4		3		2		1	
3												
4	7		8		9		10		11		12	
5												
6	18		17		16		15		14		13	
7												
8	19		20		21		22		23		24	
9												
10	30		29		28		27		26		25	
11												
12	31		32		33		34		35		36	
13												

I, Ronald R. Bischer, in a field survey on September 20, 19 93, do hereby certify that under requirements of P.A. 74, Michigan P.A. of 1970, the corner points mentioned in lines 1 and 2 above were in conformance with regulations and rules therefore as required in the current manual of survey instructions of the United States Department of the Interior, Bureau of Land Management or by a decree of a Court of Law and/or that the corner points mentioned in lines 3, 4 and 5 above were in conformance with the rules of the Michigan Board of Land Surveyors or by a Decree of a Court of Law; established, re-established, monumented, re-monumented, recovered, found as expressed below:

NOTE: Not more than 4 corners, all in the same town and range, may be recorded on this certificate.

A. Description of original monument and accessories and/or subsequent restoration:

I-3

1855 Resurvey - Geo. H. Cannon (July)

Set Wood Post

50" Elm S63°W 68 links

20" Beech S63°E 19 links

1978 - Delmar E. Porter - (Remonumentation)

Found $\frac{1}{2}$ " Rod at fence corner, replaced

with concrete monument w/brass cap.

Set three witnesses.

Corner was proven to be in the wrong location.

1992 - Delmar E. Porter

Set $\frac{1}{2}$ " Rod & Cap #15410 by

double proportion.

(Not recorded)

B. Description of corner evidence found and/or method applied in restoring or reestablishing corner:

I-3


Found $\frac{1}{2}$ " Rod and Cap #15410

Concrete Monument w/Brass Cap North 65.35'

SURVEY &
REMONUMENTATION

1993

COMMISSION

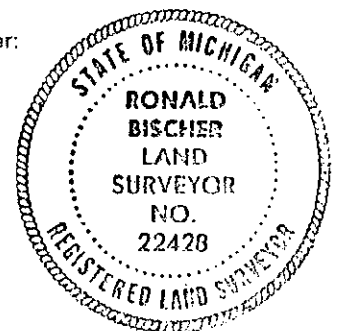

C. Description of monument for corner and accessories established to perpetuate locating the position of the corner:

I-3

 $\frac{1}{2}$ " Rod and Cap #15410

N03°W 14.74' 4" Maple

S33°E 18.69' 10" Ash

S77°W 6.91' 6" Maple

N44°E 11.96' 6" Ash

Ratified by Peer Group
in accordance with P.A. 345Chairman *Delmar E. Porter*Date December 7, 1993

*Witness tags and nails used.

Signed by Ronald R. Bischer Date 12-13-93Surveyor's Michigan License No. 22428

I-3 Corner, Section 2,3,10&11, Township 34N Range 2E

<u>Activity</u>	<u>Monument & Accessories</u>	<u>Notes</u>
1855 Resurvey Geo. H. Cannon	Set Wood Post 50" Elm S63°W 68 links 20" Beech S63°E 19 links	
1978 Remonumentation Delmar E. Porter #15410	Found $\frac{1}{2}$ " Rod at old fence corner Set Concrete Monument w/Brass Cap Set three witnesses. Recorded on Page 361, Land Recordation, November 29, 1978.	
1992 Delmar E. Porter #15410	Set $\frac{1}{2}$ " Rod & Cap #15410 by double proportion (Not recorded)	} RECORDED 9770-2
1993 Remonumentation Ronald R. Bischer #22428	Found $\frac{1}{2}$ " Rod & Cap #15410 Concrete Monument w/Brass Cap North 65.35' N03°W 14.74' 4" Maple set nail w/tag #22428 S33°E 18.69' 10" Ash set nail w/tag #22428 S77°W 6.91' 6" Maple set nail w/tag #22428 N44°E 11.96' 6" Ash set nail w/tag #22428	

#5.