

PRESQUE ISLE COUNTY
RECORDED

93 DEC 20 PM 4: 50

LAND CORNER RECORDATION CERTIFICATE
Filing Requirement of Act 74, Mich. P.A. 1970

For corners in

PRESQUE ISLE
(County)

Located In:

Corner Code #

1. Public Land Survey T 34N R 2E J-5
T R
T R
T R
2. Property Controlling S T R
in Section S T R
3. Miscellaneous S T R
Property in Sec. S T R

Janet M. Lamb
REGISTER OF DEEDS

LIBER 307 PAGE 962

Register of Deeds Stamp & File Number

4. Lot No. , Recorded Plat
5. Private Claims

I, Ronald R. Bischer, in a field survey on September 20, 19 93, do hereby certify that under requirements of P.A. 74, Michigan P.A. of 1970, the corner points mentioned in lines 1 and 2 above were in conformance with regulations and rules therefore as required in the current manual of survey instructions of the United States Department of the Interior, Bureau of Land Management or by a decree of a Court of Law and/or that the corner points mentioned in lines 3, 4 and 5 above were in conformance with the rules of the Michigan Board of Land Surveyors or by a Decree of a Court of Law; established, re-established, monumented, re-monumented, recovered, found as expressed below:

NOTE: Not more than 4 corners, all in the same town and range, may be recorded on this certificate.

A. Description of original monument and accessories and/or subsequent restoration:

J-5

1855 Resurvey - Geo. H. Cannon (July)
Set Wood Post
14" Hemlock North 13 links
17" Sugar S34°W 20 links
1988 - Ronald R. Bischer
Set ½" Rod and Cap #22428 at fence intersection in road centerline

N06°E 20.86' 5" Apple tree
S01°W 55.44' 4" Maple
N53°W 79.88' 20" Maple
Recorded on Page 750, Land
Recordation, November 4, 1988.

B. Description of corner evidence found and/or method applied in restoring or reestablishing corner:


J-5

Found ½" Rod and Cap #22428
N07°E 20.86' 5" Apple tree
S02°W 55.44' 4" Apple tree
N50°W 79.88' 20" Maple

SURVEY &
REMONUMENTATION

1993

COMMISSION

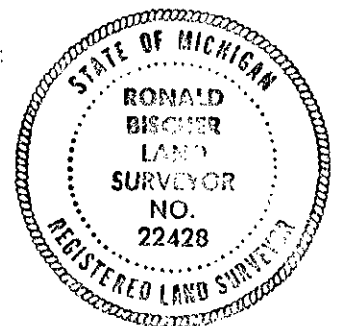

C. Description of monument for corner and accessories established to perpetuate locating the position of the corner:

J-5

½" Rod and Cap #22428
N07°E 20.86' 5" Apple tree
S02°W 55.44' 4" Apple tree
N50°W 79.88' 20" Maple
S35°W 23.58' 4" Apple tree

Ratified by Peer Group
in accordance with P.A. 345

Chairman *Delmer E. Antie*
Date December 7, 1993

*Witness tags and nails used.

Signed by Ronald R. Bischer

Date 12-13-93

Surveyor's Michigan License No. 22428