

1065

LAND CORNER RECORDATION CERTIFICATE
Filing Requirement of Act 74, Mich. P.A. 1970

LIBER 318 PAGE 734

For corners in

Presque Isle
(County)

Located In:

Corner Code #

- | | | | | | |
|---|---|------------|---|-----------|------------|
| 1. Public Land Survey | T | <u>34N</u> | R | <u>5E</u> | <u>C-7</u> |
| | T | | R | | |
| | T | | R | | |
| | T | | R | | |
| 2. Property Controlling
in Section | S | | T | R | |
| | S | | T | R | |
| 3. Miscellaneous
Property in Section | S | | T | R | |
| | S | | T | R | |

PRESQUE ISLE COUNTY
RECORDED

96 JUN 13 PM 12:25

Janet M. Lamb
REGISTER OF DEEDS

Register of Deeds Stamp & File Number

4. Lot No. _____, Recorded Plat _____
5. Private Claims _____

I, Ronald Bischer, in a field survey on 3-21, 19 96, do hereby certify that under requirements of P.A. 74, Michigan P.A. of 1970, the corner points mentioned in lines 1 and 2 above were in conformance with regulations and rules therefore as required in the current manual of survey instructions of the United States Department of the Interior, Bureau of Land Management or by a decree of a Court of Law and/or that the corner points mentioned in lines 3, 4 and 5 above were in conformance with the rules of the Michigan Board of Professional Surveyors or by a Decree of a Court of Law; established, re-established, monumented, re-monumented, recovered, found as expressed below:

NOTE: Not more than 4 corners, all in the same town and range, may be recorded on this certificate.

	A	B	C	D	E	F	G	H	I	J	K	L	M
2	6		5		4		3		2		1		
3													
4	7		8		9		10		11		12		
5													
6	18		17		16		15		14		13		
7													
8	19		20		21		22		23		24		
9													
10	30		29		28		27		26		25		
11													
12	31		32		33		34		35		36		
13													


A. Description of original monument and accessories and/or subsequent restoration:

C-7
1856 Alfred Millend Set Wood Post
N34°E 38 links 9" Sugar
S65°W 28 links 10" Elm
7-13-77 Ronald Bischer found RxR spike left 3 witnesses
7-13-77 Delmar Porter found RxR spike, left 3 witnesses
10-16-79 Delmar Porter Set ½" rod from witnesses, set mon. box left 3 witnesses
4-27-84 Delmar Porter found ½" rod in mon. box left 3 witnesses
6-14-89 Duane R. MacNeill found mon. box

B. Description of corner evidence found and/or method applied in restoring or reestablishing corner:

1-13-92 Thomas L. Fabis found ½" rod in mon box, left 3 witnesses
7-28-95 Norman Quaine ½" rod & cap #33984 in mon box left 4 witnesses

C-7
3-21-96 Ronald Bischer found ½" rod & cap #33984 in Mon. box
N44°W 55.47' P. pole
S26°W 35.98' P. pole
S81°W 147.17' P. pole
S39°E 68.26' 9" Cedar

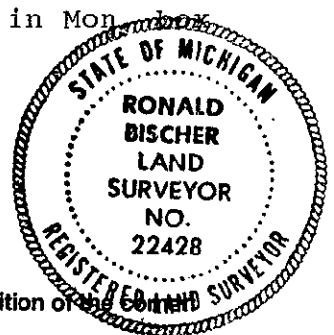

C. Description of monument for corner and accessories established to perpetuate locating the position of the corner:

C-7
3-21-96 Ronald Bischer
½" Rod & Cap #33984 in Mon. Box
N40°W 55.47' P. pole (new pole)
S20°W 35.98' P. pole (new pole)
S78°W 147.17' P. pole
S41°E 68.26' 9" Cedar

Ratified by _____ Group
in accordance with P.A. 345

Chairman *Delmar E. Porter*

Date 6/12/96

Signed by Ronald R. Bischer

Date 6-6-96

Surveyor's Michigan License No. 22428