

1063

LAND CORNER RECORDATION CERTIFICATE
Filing Requirement of Act 74, Mich. P.A. 1970

For corners in
Presque Isle
(County)

Located In:

Corner Code #

- | | | | | | |
|------------------------------------|---|-----|---|----|------|
| 1. Public Land Survey | T | 34N | R | 5E | C-11 |
| | T | | R | | |
| | T | | R | | |
| | T | | R | | |
| 2. Property Controlling in Section | S | | T | R | |
| | S | | T | R | |
| 3. Miscellaneous | S | | T | R | |
| Property in Section | S | | T | R | |

PRESQUE ISLE COUNTY
RECORDED

96 JUN 13 PM 12:24

Janet M. Land
REGISTER OF DEEDS

Register of Deeds Stamp & File Number

4. Lot No. _____, Recorded Plat _____
5. Private Claims _____

I, Ronald Bischer, in a field survey on 3-25, 19 96, do hereby certify that under requirements of P.A. 74, Michigan P.A. of 1970, the corner points mentioned in lines 1 and 2 above were in conformance with regulations and rules therefore as required in the current manual of survey instructions of the United States Department of the Interior, Bureau of Land Management or by a decree of a Court of Law and/or that the corner points mentioned in lines 3, 4 and 5 above were in conformance with the rules of the Michigan Board of Professional Surveyors or by a Decree of a Court of Law; established, re-established, monumented, re-monumented, recovered, found as expressed below:

NOTE: Not more than 4 corners, all in the same town and range, may be recorded on this certificate.


| | A | B | C | D | E | F | G | H | I | J | K | L | M |
|----|----|---|----|---|----|---|----|---|----|---|----|---|---|
| 2 | 6 | | 5 | | 4 | | 3 | | 2 | | 1 | | |
| 3 | | | | | | | | | | | | | |
| 4 | 7 | | 8 | | 9 | | 10 | | 11 | | 12 | | |
| 5 | | | | | | | | | | | | | |
| 6 | 18 | | 17 | | 16 | | 15 | | 14 | | 13 | | |
| 7 | | | | | | | | | | | | | |
| 8 | 19 | | 20 | | 21 | | 22 | | 23 | | 24 | | |
| 9 | | | | | | | | | | | | | |
| 10 | 30 | | 29 | | 28 | | 27 | | 26 | | 25 | | |
| 11 | | | | | | | | | | | | | |
| 12 | 31 | | 32 | | 33 | | 34 | | 35 | | 36 | | |
| 13 | | | | | | | | | | | | | |

A. Description of original monument and accessories and/or subsequent restoration:

C-11
1856 Alfred Millend Set Wood Post
S30°E 16 links 24" Hemlock
N60°W 11 links 12" Hemlock
1-26-89 Norman Quaine found 1/2" rod with cap (not legible)
left 3 witnesses

B. Description of corner evidence found and/or method applied in restoring or reestablishing corner:

C-11
3-25-96 Ronald Bischer found 1/2" rod & cap # 15410
N37°E 41.15' P. Pole
N59°W 121.00' White Pine
S77°W 89.13' Fence post

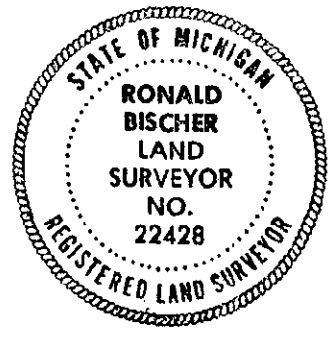

C. Description of monument for corner and accessories established to perpetuate locating the position of the corner:

C-11
3-25-96 Ronald Bischer
1/2" rod & cap # 15410
N28°E 41.15' Power pole
N59°W 121.00' White pine
S71°W 88.86' Fence post
S14°E 31.51' 4" Aspen

Ratified by Peer Group
in accordance with P.A. 345
Chairman *Delmer S. Pate*
Date 6/12/96

Signed by Ronald R. Bischer

Date 6-6-96

Surveyor's Michigan License No. 22428