

2606

1997 PRESQUE ISLE COUNTY STATE OF MICHIGAN REMONUMENTATION

LAND CORNER RECORDATION CERTIFICATE
Filing Requirement of Act 74, Mich. P.A. 1970

LIBER 325 PAGE 087

For corners in

Presque Isle
(County)

Located in:

Corner Code #

Belknap Twp.

- | | | |
|------------------------------------|------------|-----|
| 1. Public Land Survey | T 34N R 5E | 1 1 |
| | T R | |
| | T R | |
| | T R | |
| | T R | |
| 2. Property Controlling in Section | S T R | |
| | S T R | |
| 3. Miscellaneous Property in Sec. | S T R | |
| | S T R | |

PRESQUE ISLE COUNTY
RECORDED

97 DEC 18 AM 9:55

James M. Smith
REGISTER OF DEEDS

Register of Deeds Stamp & File Number

4. Lot No. _____, Recorded Plat _____
5. Private Claims _____

I, James A. Beck, in a field survey on Oct. 30, 1997 do hereby state that under requirements of P.A. 74, Michigan P.A. of 1970, the corner points mentioned in lines 1 and 2 above were in conformance with regulations and rules therefore as required in the current manual of survey instructions of the United States Department of the Interior, Bureau of Land Management or by a decree of a Court of Law and /or that the corner points mentioned in lines 3, 4 and 5 above were in conformance with the rules of the Michigan Board of Land Surveyors or by a Decree of a Court of Law; established, re-established, monumented, recovered, found as expressed below:

NOTE: Not more than 2 corners, all in the same town and range, may be recorded on this certificate.

	A	B	C	D	E	F	G	H	I	J	K	L	M
1													
2	6		5		4		3		2		1		
3													
4	7		8		9		10		11		12		
5													
6	18		17		16		15		14		13		
7													
8	19		20		21		22		23		24		
9													
10	30		29		28		27		26		25		
11													
12	31		32		33		34		35		36		
13													

A. Description of original monument and accessories and/or subsequent restoration:

- I 1 Date: 1840 G.L.O. by John Hodgson
"Set post Cor. Sections 34 & 35" (T35N, R5E)
Sugar 18 N33W 17
Beech 8 N7E 16
Date: 1856 G.L.O. by Alfred Millerd
old Cor. of Sec. 2 & 3 45 links East effaced"
Sugar 12 S48W 20

SEE REVERSE SIDE FOR ADDITIONAL ACTIVITY
AT CORNER

SURVEY &
REMONUMENTATION

JAN 14 1998

SECTION

B. Description of corner evidence found and/or method applied in restoring or reestablishing corner:
I 1

Found 5/8" iron rod in monument box, set P.S. 21559 cap on rod


Ratified by Peer Group
in accordance with P.A. 340
Chairman Norman J. Quast
Date 11/13/97

C. Description of monument for corner and accessories established to perpetuate locating the position of the corner:
I 1

- Monument: Found 5/8" iron rod in monument box, set P.S. 21559 cap on rod
Accessories:
S 21°E 65.31 ft., R.L.S. 15410 (Delmer Porter) tag in telephone pole
N24°E 94.12 ft., " " in telephone pole
S 35°E 90.74 ft., center of metal fence corner post of Natural Gas Sta.
S 60°W 52.01 ft, R.L.S. 15410 tag in power pole
Corner falls at centerline- centerline blacktop roads

Signed by James A. Beck
Surveyor's Michigan License No. 21559

Date 12/8/1997

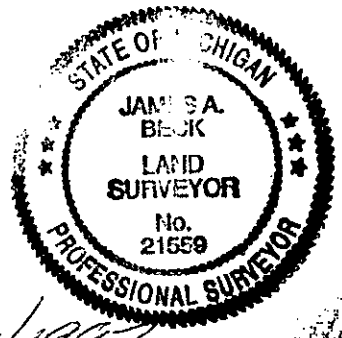

- Sep. 12, 1942 From page 32 County Surveyors Notes in Book labeled "Established Section Corners" located in the Register of Deeds vault in Presque Isle County Court House.
Entry by G.F. DeLaMater Reg. No. 2674
"September 2, 1942 Survey for Mrs. Barbara Petit"
NE Cor Sec 3
"found 1" steel bar in corner"
Elm 16 S14W 69.9'
Elm 20 S81E 99.1
Elm 12 N 69W 66.5
Sug 20 N68E 132.7
- Aug. 30, 1950 Survey drawing and field notes of same by Scott Engineering for Barbara Petit
"Sec Cor to Secs 2-3 on Town Line T34N, R5E, Boat Spike in B. Top"
Wits-
Elm 18" N65°W 69.2
Elm 24" S70°E 96.6
Elm 16" S-W 106.95
- Sep. 25, 1971 (2)P.A. 132 Certificate of Survey s by Reino E. Alanen Reg. No. 12042 for Virginia Petit
"Found 1/2" ø pin in corner"
References:
Nail-P.Pole S57°-45'W 52.10'
Nail-P.Pole N22°00'E 94.87'
CL cor. post-Nat. Gas Sta. Encl. S35°-30'E 91.05'
- 1974 P.A. 132 Survey by Delmer E. Porter Reg. No. 15410 Recorded in Liber 207, Page 83
"NW" (Northwest Corner Sec. 2)
"Cabin Spike"
S50°W 52.00 P. Pole
S25°E 65.20 U.Pole
- June 14, 1976 P.A. 132 Survey by Delmer E. Porter Reg. No. 15410 Recorded in Liber 213, Page 195
"NE Cor. Sec. 3 T34N, R5E"
"Cabin Spike"
S50°W 52.00' P. Pole
S25°E 65.20' U.Pole
- Nov 4, 1977 P.A. 132 Certificate of Survey by Reino E. Alanen Reg. No. 12042 for Edward Steinke
"pt. B"
S45°W 51.8' to REA pole & S27°E 65.1' to REA pole
- Sep 22, 1978 P.A. 74 (Land Corner Recordation) Certificate page 280 by Delmer E. Porter Reg. No. 15410
Part A. " 5/8" Rod (Porter Survey)"
S 25°E 65.20' P. Pole
S 50°W 52.00' P.Pole
Part B. " same as above"
Part C. " 5/8" Rod in Mon. Box
N 63°W 69.47' 26" Stump
S 60°W 52.01' P.Pole
S 21°E 65.42' P.Pole
- Nov 10, 1979 P.A. 74 (Land Corner Recordation) Certificatepage 439 by Herbert Fluaharty L.S. 18223
Part A. no entry
Part B. " Fd. 5/8" iron in Mon Box on CL Road E-W & N-S"
Part C. " 5/8" iron in Mon, Box;
L.S. 15410 tag in East Side P.P., S22°E 65.22'
L.S. 15410 tag in P.P., S 60°W 52.02'
P.K. Nail in P.P., N 23°E 94.86'
- Sep. 25 1984 P.A. 132 Survey Certificate by James A. Beck
"SE Cor. Sec 34, T35N, R5E, Iron Rod in Mon Box"
S 15°E 65.25' tag in T.P.
S 60°W 52.00' Tag in P.P.
S55°W 55.40' Rd. sign
N25°E 94.8' Tel pole