

LIBER 325 PAGE 202

LAND CORNER RECORDATION CERTIFICATE
Filing Requirement of Act 74, Mich. P.A. 1970

97 DEC 23 AM 11:19

For corners in

Presque Isle
(County)

Located In:

Corner Code #

- | | | | |
|------------------------------------|---|----------|------|
| 1. Public Land Survey | | T34NR 5E | L-13 |
| | | T R | |
| | | T R | |
| | | T R | |
| 2. Property Controlling in Section | S | T R | |
| | S | T R | |
| 3. Miscellaneous | S | T R | |
| Property in Sec. | S | T R | |

Janet M. Stambaugh
REGISTER OF DEEDS

SURVEY &
REMONUMENTATION

JAN 14 1998

SECTION

Register of Deeds Stamp & File Number

4. Lot No. _____, Recorded Plat _____
5. Private Claims _____

I, Delmer E. Porter, in a field survey on 3-27, 19 97 do hereby state that under requirements of P.A. 74, Michigan P.A. of 1970, the corner points mentioned in lines 1 and 2 above were in conformance with regulations and rules therefore as required in the current manual of survey instructions of the United States Department of the Interior, Bureau of Land Management or by a decree of a Court of Law and/or that the corner points mentioned in lines 3, 4 and 5 above were in conformance with the rules of the Michigan Board of Land Surveyors or by a Decree of a Court of Law; established, re-established, monumented, recovered, found as expressed below:

NOTE: Not more than 2 corners, all in the same town and range, may be recorded on this certificate.

	A	B	C	D	E	F	G	H	I	J	K	L	M
1													
2	6		5		4		3		2		1		
3													
4	7		8		9		10		11		12		
5													
6	18		17		16		15		14		13		
7													
8	19		20		21		22		23		24		
9													
10	30		29		28		27		26		25		
11													
12	31		32		33		34		35		36		
13													

A. Description of original monument and accessories and/or subsequent restoration:

L-13

GLO Notes Set 1/4 Sec Post
John Hodgson Balsam 12" N68°E 51 Lk
1840 Beech 12" N26°W 12 Lk

D. Porter #15410 1/2" Rod & Cap in Mon Bo
Act 132 Survey N45°E 53.45' P. Pole
July 17, 1980 S37°E 53.39' P. Pole
Rec. Oct 24, 1980 S49°W 47.11' P. Pole
L. 237 Pg. 757

"Continued on Back"

B. Description of corner evidence found and/or method applied in restoring or reestablishing corner:

L-13


Fd. 1/2" Rod in Mon Box
@ Road C/L - C/L Int.
Put Cap #33984 On
S33°E 53.44' P. Pole
S52°W 47.02' Guy Pole
N48°E 53.60' Guy Pole

Ratified by Peer Group
in accordance with P.A. 345
Chairman *William J. Quinn*
Date 12/04/97

C. Description of monument for corner and accessories established to perpetuate locating the position of the corner:

L-13

1/2" Rod & Cap #33984 in Mon Box
@ Road C/L - C/L Int.
S33°E 53.44' P. Pole
S52°W 47.02' Guy Pole
N48°E 53.60' Guy Pole
S70°W 69.68' 23" Maple

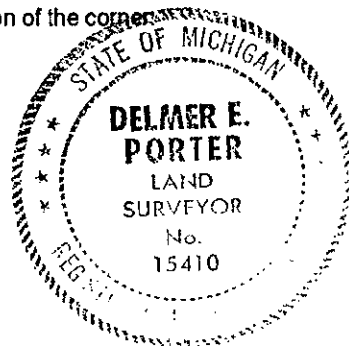

Signed by *Delmer E. Porter*
Surveyor's Michigan License No. 15410

Date 12/18/97

A Continued:

R. Bischer, #22428
Act 74 Filing
Feb. 2, 1983
L. 1 Pg. 629

Fd. 1/2" Rod & Cap (No indication of
In Mon Box who's)
Left 1/2" Rod & Cap in Mon Box
N45°E 53.45' P. Pole
S49°W 47.11' P. Pole
S37°E 53.59' P. Pole