

LAND CORNER RECORDATION CERTIFICATE
Filing Requirement of Act 74, Mich. P.A. 1970

97 DEC 23 AM 11:17

For corners in

Presque Isle
(County)

Located In:

Corner Code #

- | | | | |
|------------------------------------|---|----------|-----|
| 1. Public Land Survey | | T 34N 5E | M-1 |
| | | T R | |
| | | T R | |
| | | T R | |
| | | T R | |
| 2. Property Controlling in Section | S | T R | |
| | S | T R | |
| 3. Miscellaneous | S | T R | |
| Property in Sec. | S | T R | |

Janet M. Shantz
REGISTER OF DEEDS

SURVEY &
REMONUMENTATION

JAN 14 1998

SECTION

Register of Deeds Stamp & File Number

4. Lot No. _____, Recorded Plat _____
5. Private Claims _____

I, Delmer E. Porter, in a field survey on 11-5, 1997 do hereby state that under requirements of P.A. 74, Michigan P.A. of 1970, the corner points mentioned in lines 1 and 2 above were in conformance with regulations and rules therefore as required in the current manual of survey instructions of the United States Department of the Interior, Bureau of Land Management or by a decree of a Court of Law and/or that the corner points mentioned in lines 3, 4 and 5 above were in conformance with the rules of the Michigan Board of Land Surveyors or by a Decree of a Court of Law; established, re-established, monumented, recovered, found as expressed below:

NOTE: Not more than 2 corners, all in the same town and range, may be recorded on this certificate.

	A	B	C	D	E	F	G	H	I	J	K	L	M
1													
2	6			5			4			3		2	1
3													
4	7			8			9			10		11	12
5													
6	18			17			16			15		14	13
7													
8	19			20			21			22		23	24
9													
10	30			29			28			27		26	25
11													
12	31			32			33			34		35	36
13													

A. Description of original monument and accessories and/or subsequent restoration:

M-1		
GLO Notes	Old Town Cor Set in 1840	Section 6 Survey
John Hodgson	Birch 9" N08°E 16 Lk	T34N, R6E, By
1840	Birch 8" S42°W 24 Lk	Francis E Spicer
		#7877
		9/29/62
		Twp. Cor removed during Quarry operations. Mr. Spicer recreated corner Position from existing Mon. & GLO recorded distances. Survey done for MI Limestone Corp.

B. Description of corner evidence found and/or method applied in restoring or reestablishing corner:

M-1	
Nov. 5, 1997	Witness to North 1/8th Corner
Survey by	on East Line Section 1
Porter's Survey	Fd. 1/2" Rod & 4"X4" Post
Survey Re-Est.	S51°W 19.20' 8" Aspen
Spicer 1/8th Cor.	N77°W 21.96' 3" Balsam
Asper Spicer	N18°E 7.74' 2" Balsam
Notes	N74°E 9.26' 4" Balsam
	N00°21'55" W 105.13' 1/2" Rod & Cap #33984
	For Reference Iron
	See attached sketch for survey notes.

C. Description of monument for corner and accessories established to perpetuate locating the position of the corner:

M-1	
Corner Position in C/L of	
East-West Quarry drain	
S00°21'55"E 776.23'	1/2" Rod & Cap #33984 at Quarry Ridge Top
S00°21'55"E 881.36'	1/2" Rod & Cap #33984 - for north 1/8th
	on East line of Section 1
S87°54'01"W 5000.72'	1/2" Rod & Cap #33984 at Quarry Ridge Top



Signed by Delmer E. Porter
Surveyor's Michigan License No. 15410

Date 12/18/97

Ratified by Peer Group
in accordance with P.A. 345

Norman J. Charni
12/4/97

1997 REMONUMENTATION
SECTION 1, T34N R5E
BELKNAP TOWNSHIP, PRESQUE
ISLE COUNTY, MICHIGAN.

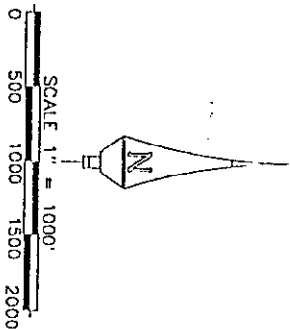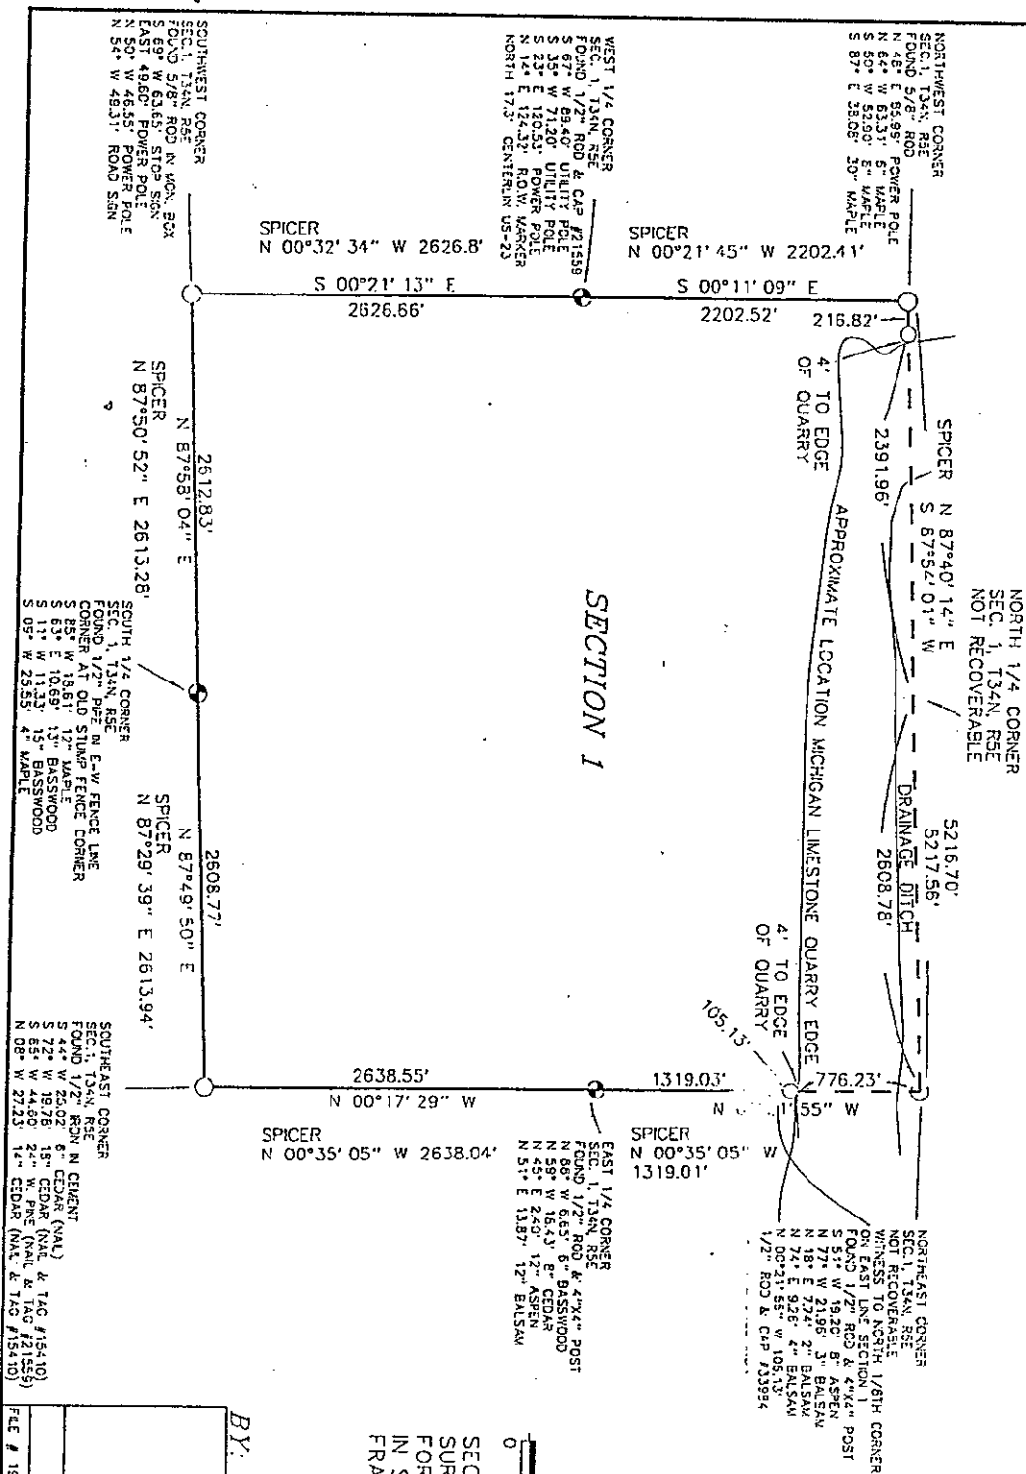

SECTION RETRACEMENT OF
SURVEY BY SPICER ENGINEERING
FOR UNITED STATES STEEL CORP.
IN SEPTEMBER, 1962
FRANCIS SPICER RLS 7877

BY:

PORTER'S SURVEY, P.C.
21529 M-68 HWY.
P.O. BOX 159
ONAWAY, MICHIGAN 49765
PH. (517) 733-8813

CHECKED BY : NJO
DRAWN BY: B.C.P.